


T.3S. R.46E. W.M.

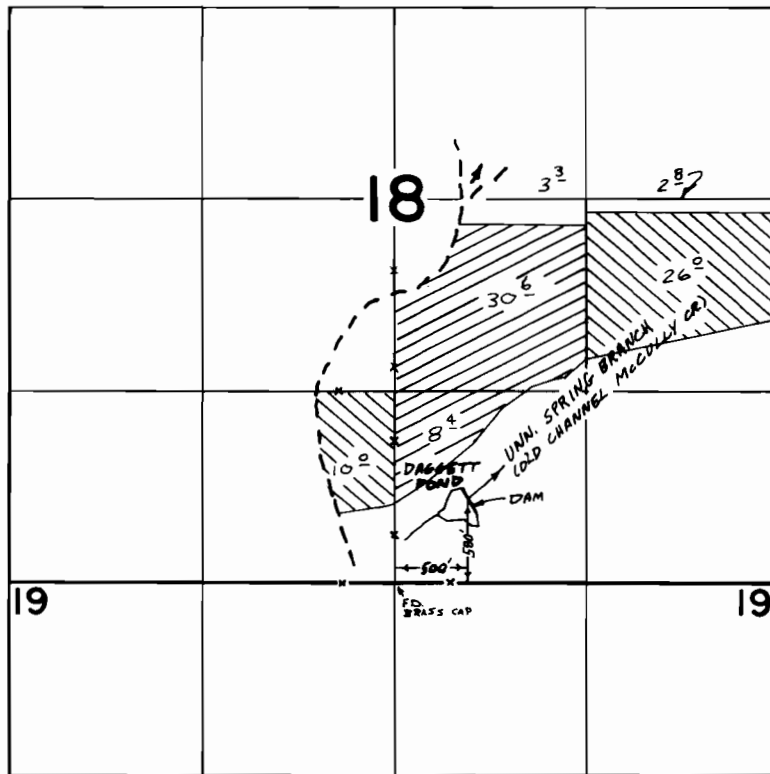

48838



53926

FINAL PROOF SURVEY
UNDER

53926 40234
R-48837 R-5835
Application No. 48838 Permit No. 36071
IN NAME OF

ROY W. DAGGETT & EMILY DAGGETT

Surveyed NOV. 6 1975 by L. H. NUNN
AUG. 18 81 V.L. Church