


T. 1S., R. 45E., W.M.

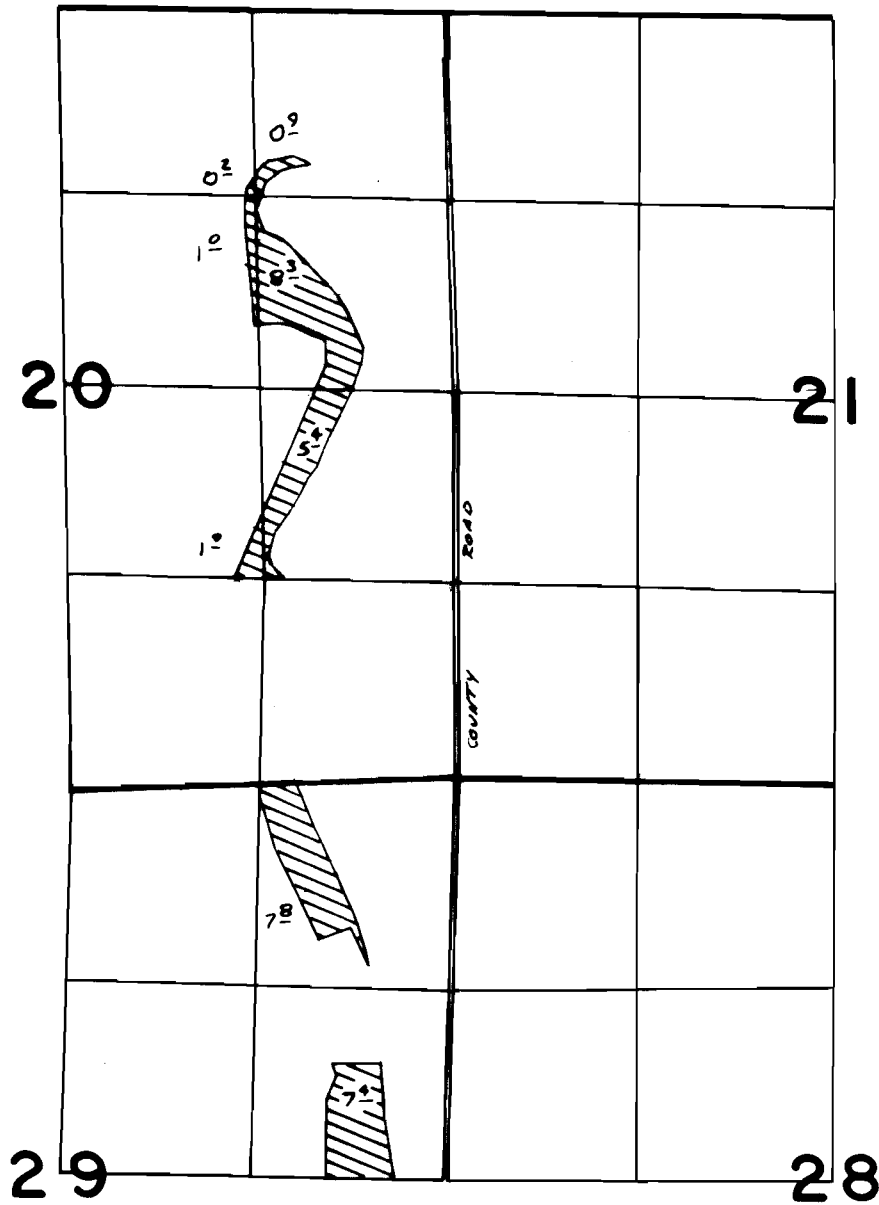

FINAL PROOF SURVEY
UNDER

Application No. **54316** Permit No. **40726**
IN NAME OF

..... **ROY W. DAGGETT**

Surveyed **5-12** 19**81**, by *Kermon Lee Church*