


T. 7 S., R. 40 E., W.M.

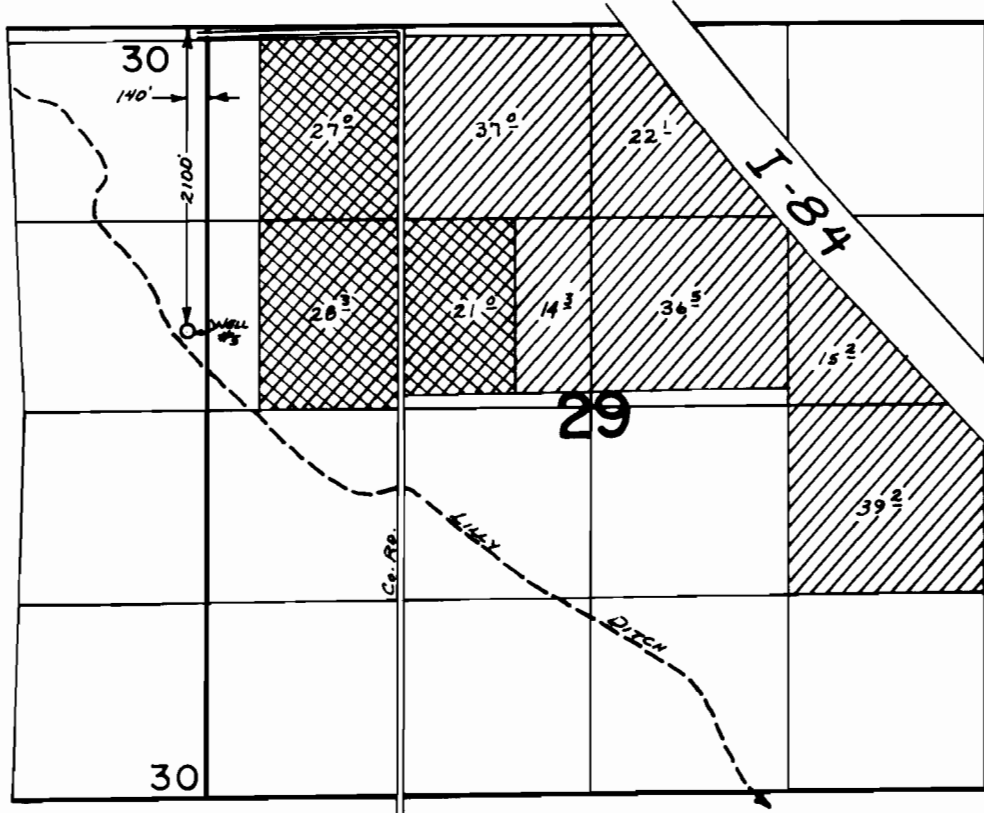

SCALE: 1" = 1320'

-  PRIMARY
-  SUPPLEMENTAL

FINAL PROOF SURVEY UNDER

Application No. G-5489 Permit No. G-4837....
IN NAME OF

CONNECTICUT...GEN...LIFE...INS...CO.

Surveyed Aug...3... 1981., by V.L. CHURCH....

