


T13S. R7W. WM.

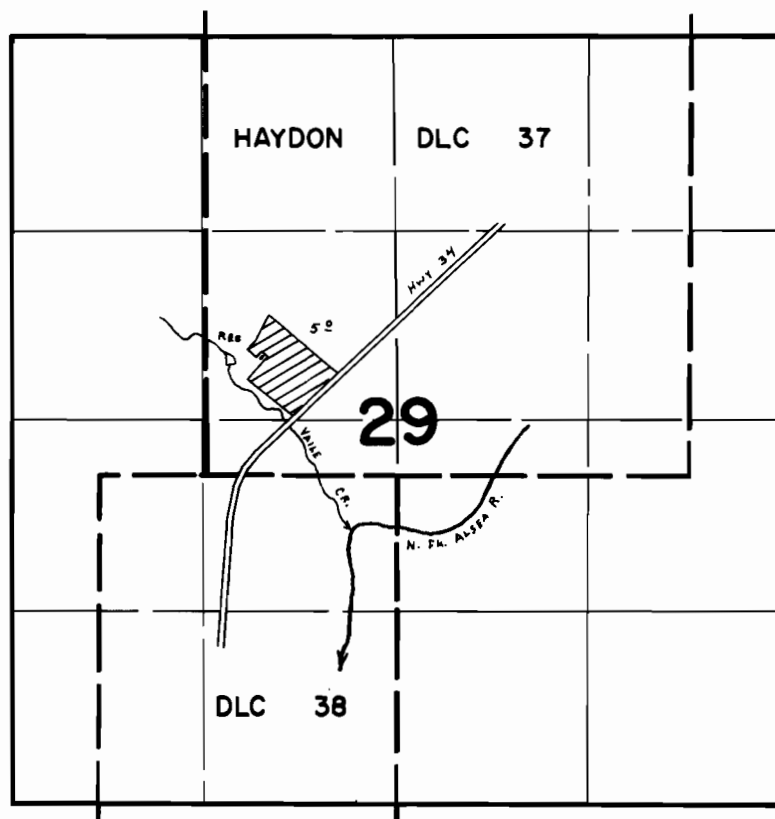

DAM LOC: 760' N. & 160' E. fr. S.W. COR. HAYDON DLC 37.

FINAL PROOF SURVEY
UNDER

Application No. 51796.. Permit No. 39020.....
IN NAME OF

RICHARD K. & DOROTHY A. JONES

Surveyed Oct. 5, 1979, by C. L. HUGHES.....