


T. 5S., R. 1E., W.M.

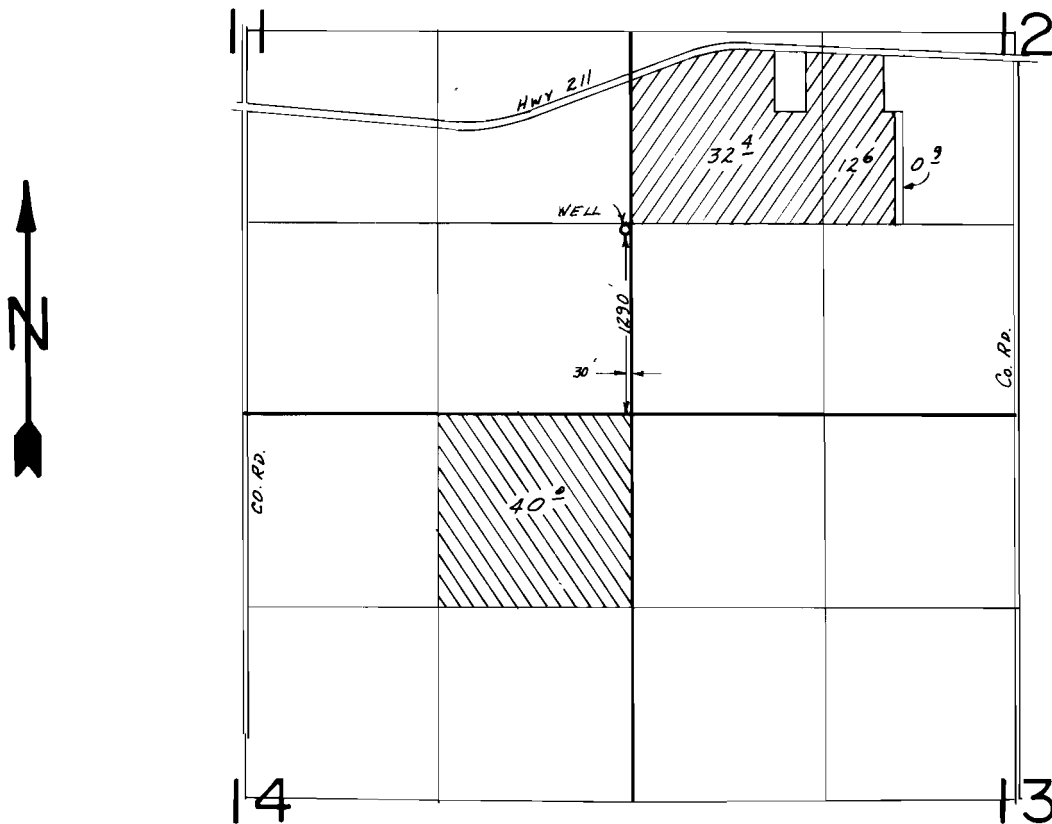


SCALE: 1"=1320'

FINAL PROOF SURVEY
UNDER

G-10739

G-9819

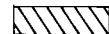

Application No. G-10936 Permit No. G-10098



IN NAME OF

PAUL E. LUCHT

Surveyed Aug. 7, 1984, by J.R. WOODROOF.