


T. 5S., R. 1E., W.M.

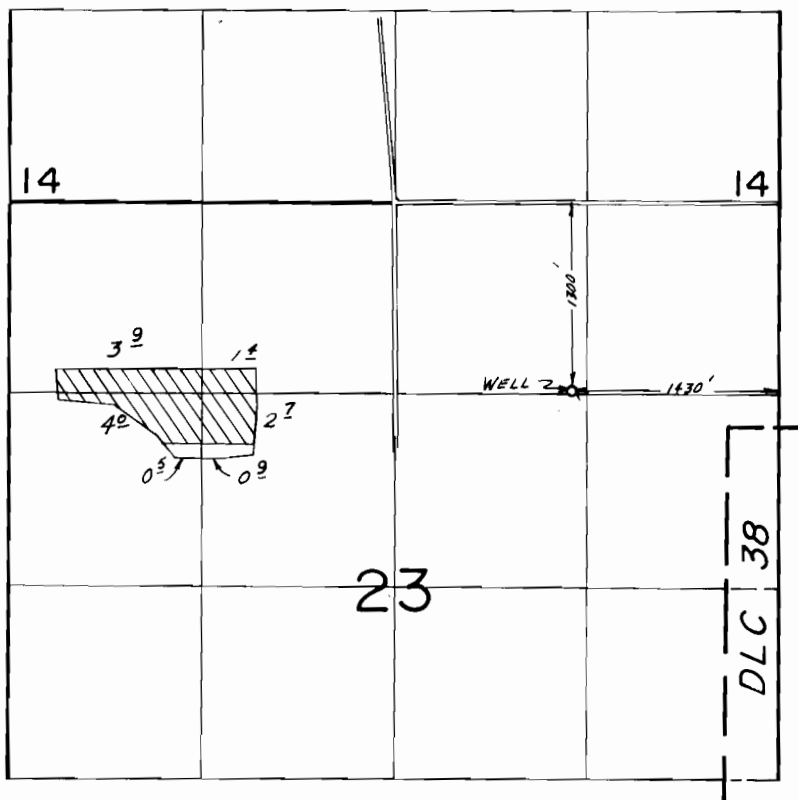

SCALE: 1" = 1320'

FINAL PROOF SURVEY
UNDER

Application No. G-10738 Permit No. G-9818.....
IN NAME OF

.....CRESTVIEW FARMS, INC.....

Surveyed Aug. 7..... 19.84, by J. R. WOODROOF.