


# T. 2S. R. 3E. W.M.

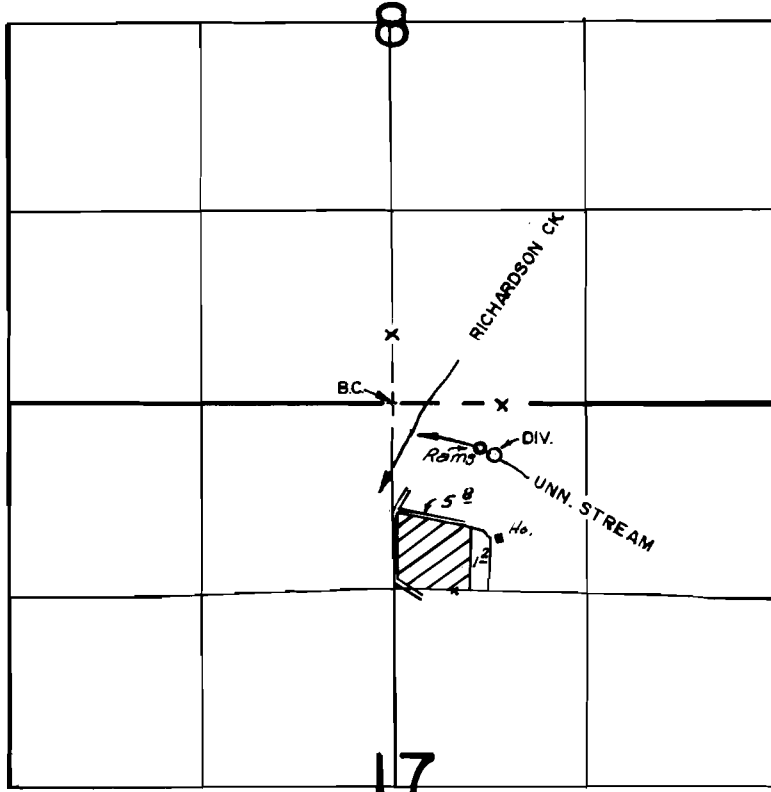

DIV. PT. LOC.: 350'S. & 680'E. FROM N. 1/4 COR. SEC. 17

## FINAL PROOF SURVEY UNDER

Application No. ~~43955~~ Permit No. 32858.....  
IN NAME OF

.....JACK. MITUNIEWICZ.....

Surveyed MAR. 25. 1980. by R.G. MUCKEN.....