


T.4S. R.2E. WM.

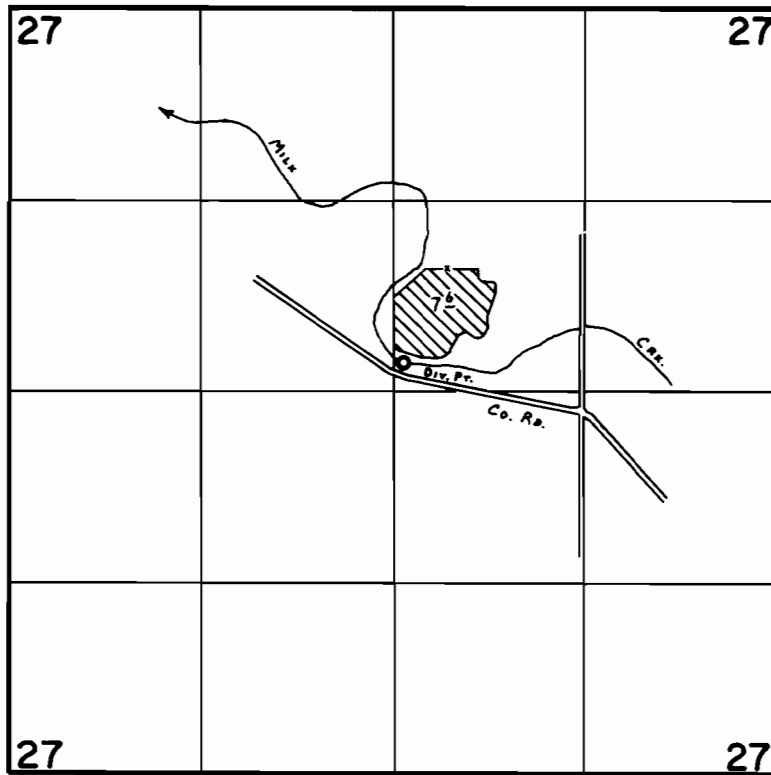

Div. Pr. Loc: 190' N. & 70' E. fr. C. 1/4 Cor. SEC. 27.

FINAL PROOF SURVEY
UNDER

Application No. 51585 Permit No. 38911
IN NAME OF

MRS. JOHN LOFTUS

Surveyed Oct. 11 1979, by C. L. HUGHES