


T.2S.R.4E.W.M.

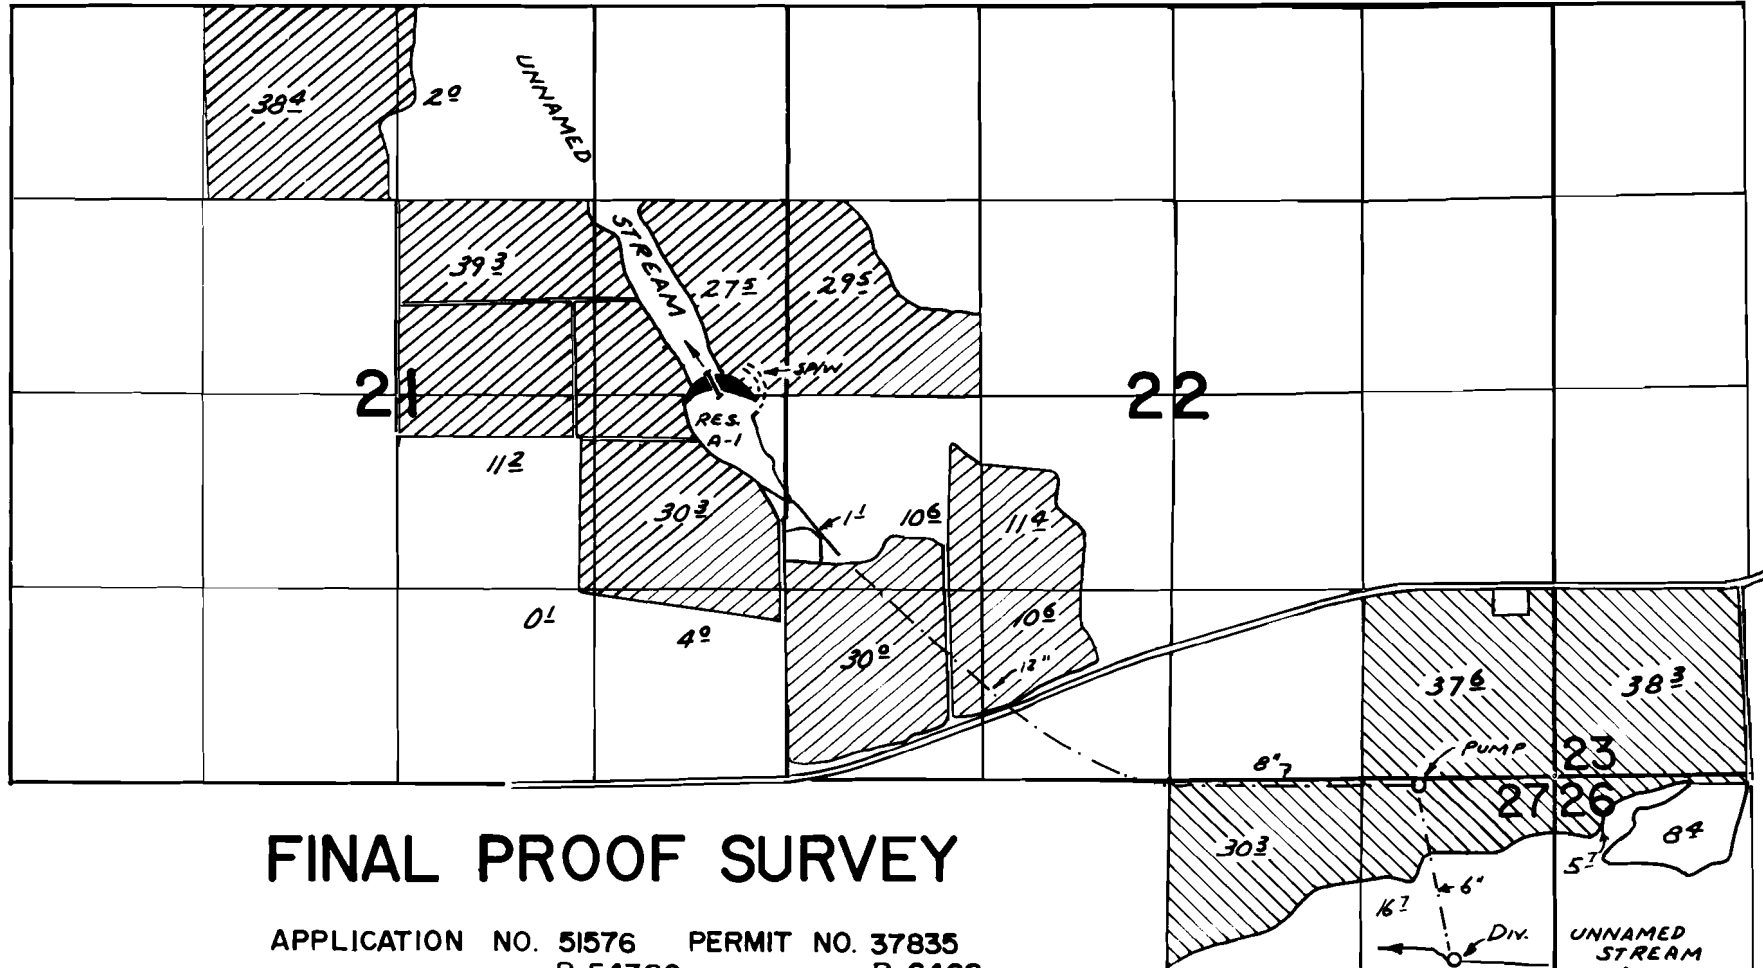

FINAL PROOF SURVEY

APPLICATION NO. 51576 PERMIT NO. 37835
 R-54360 R-6468
 54361 40582
 TRANSFER NO. 3024

For

SANDY FARMS

Surveyed APR. 4, 1980 by R. MUCKEN

DIV. PTS. LOC. RES. - 2730' N. & 500' W.; STREAM -
 1240' S. & 4550' E., BOTH FROM S.E. COR. SEC. 21
 APPL. 51576 PRIM. SUPPL.