


T. 5 S., R. 3 E., W. M.

SECTION 9

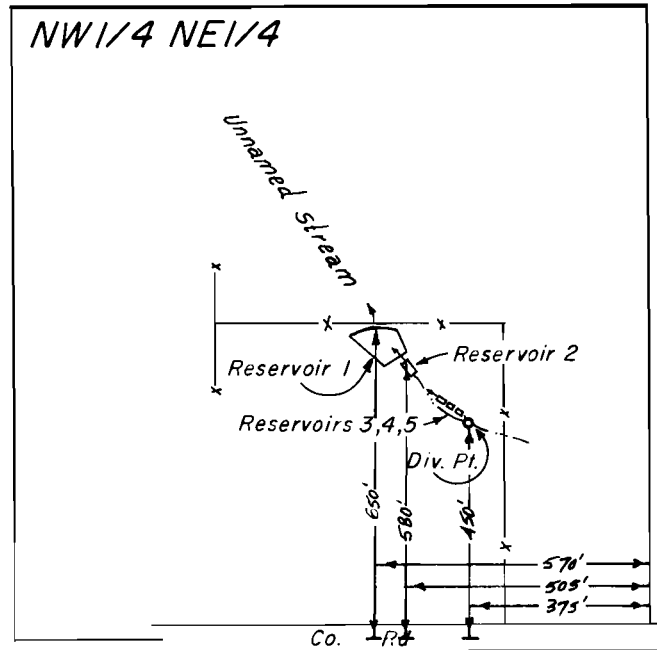

SCALE 1" = 400'

FINAL PROOF SURVEY

UNDER

58507 44404
Application No. R-58638, Permit No. R-7934

IN NAME OF

ROGER L. ELI

Surveyed MAY 22, 1980, by *[Signature]*