


# T. 5 S., R. 3 E., W. M.

## SECTION 9

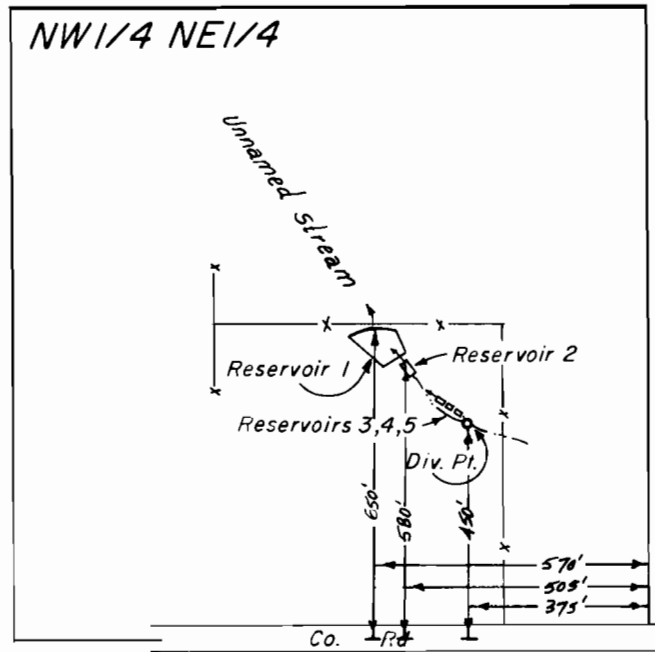

SCALE 1" = 400'

### FINAL PROOF SURVEY

UNDER

58507                      44404  
Application No. R-58638, Permit No. R-7934

IN NAME OF

**ROGER L. ELI**

Surveyed MAY 22, 1980, by *[Signature]*