

RECEIVED


JUN 18 1974

STATE ENGINEER
SALEM, OREGON

RECEIVED

JUL 9 1974

STATE ENGINEER
SALEM, OREGON

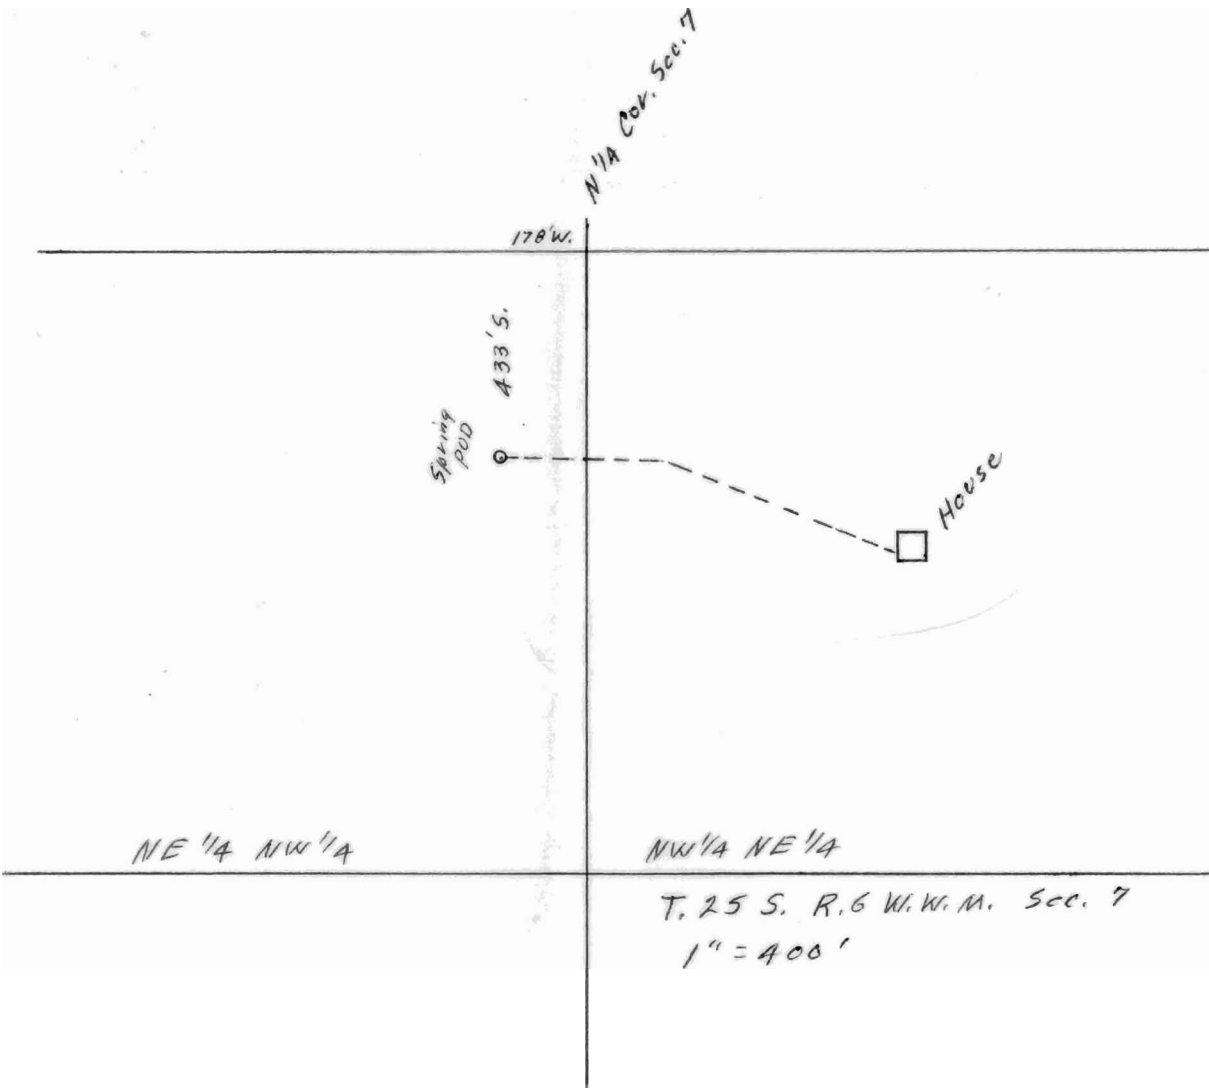

Application No. 52166
Permit No. 39284