


T. 32 S., R. 6 W., W.M.

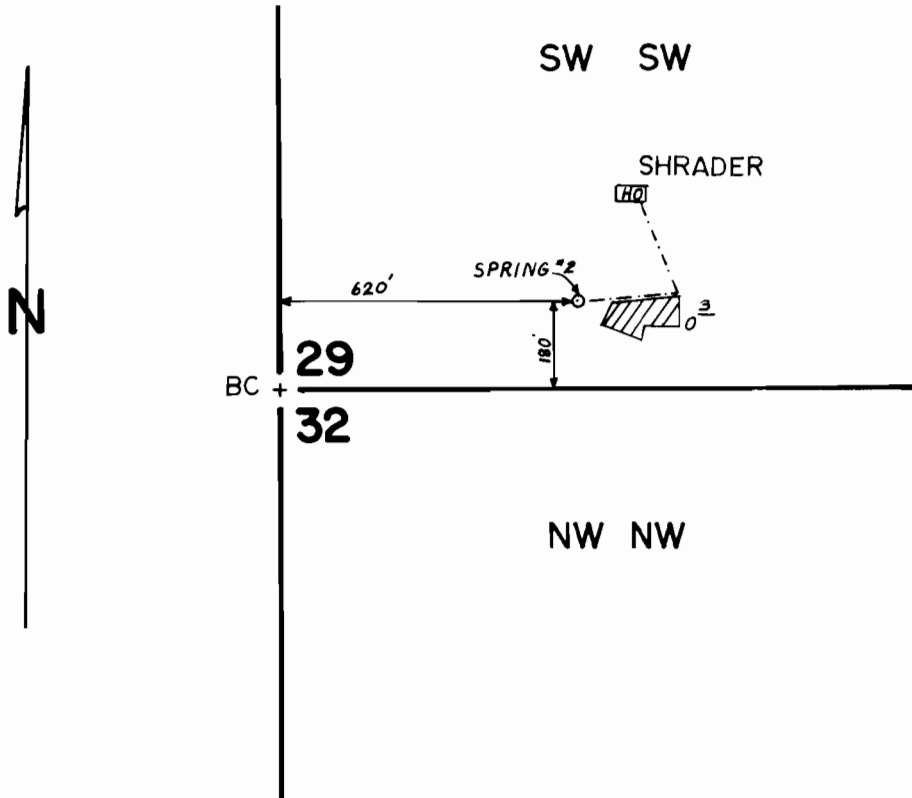

SCALE: 1" = 400'

FINAL PROOF SURVEY
UNDER

Application No. 60143... Permit No. 44864...
IN NAME OF

L.H. and MARY FREEMAN

Surveyed AUG. 14, 1984, by J. L. Lasham