


P 39135
C-52970

T.14S.,R.30E.,W.M.

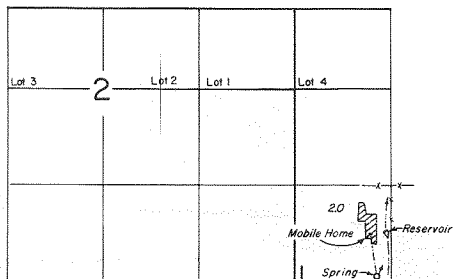

DIVERSION POINTS LOCATED: SPRING- 80' N. & 200' W.; RESERVOIR-
700' N. & 70' W.; both from the SE corner SW1/4 SW1/4

FINAL PROOF SURVEY
UNDER

R-52196 R-6263
Application No. 51765 Permit No. 39135
IN NAME OF
DOUGLAS H. BEEDLE

Surveyed AUG. 28, 1981, by *W. H. [Signature]*

PTS-1981-B