


**T.39S. R.3W. W.M.**

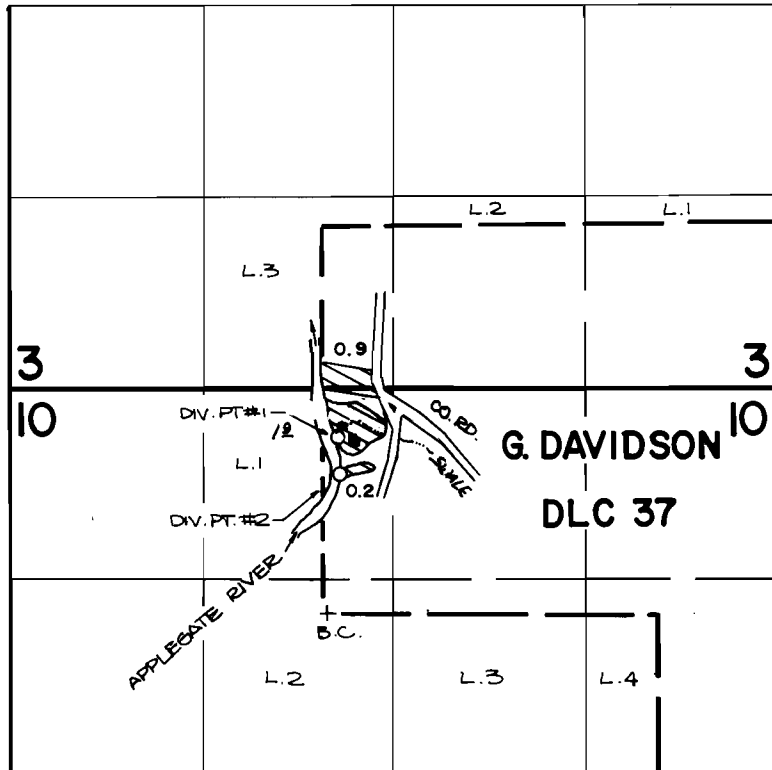

DIV. PT. #1 IS LOCATED 350'S. AND 350'W.; DIV. PT. #2 IS LOCATED 500'S. AND 350'W.; BOTH FROM THE N. 1/4 CORNER OF SECTION 10.

**FINAL PROOF SURVEY**  
UNDER

Application No. **63219** Permit No. **46703**  
IN NAME OF

**BEN C. GERWICK, JR. AND/OR MARTELLE GERWICK**

Surveyed **MAY.19 1983**, by **B. JAMES**