


G. 8601
52874

T.25S.,R.13E.,W.M.

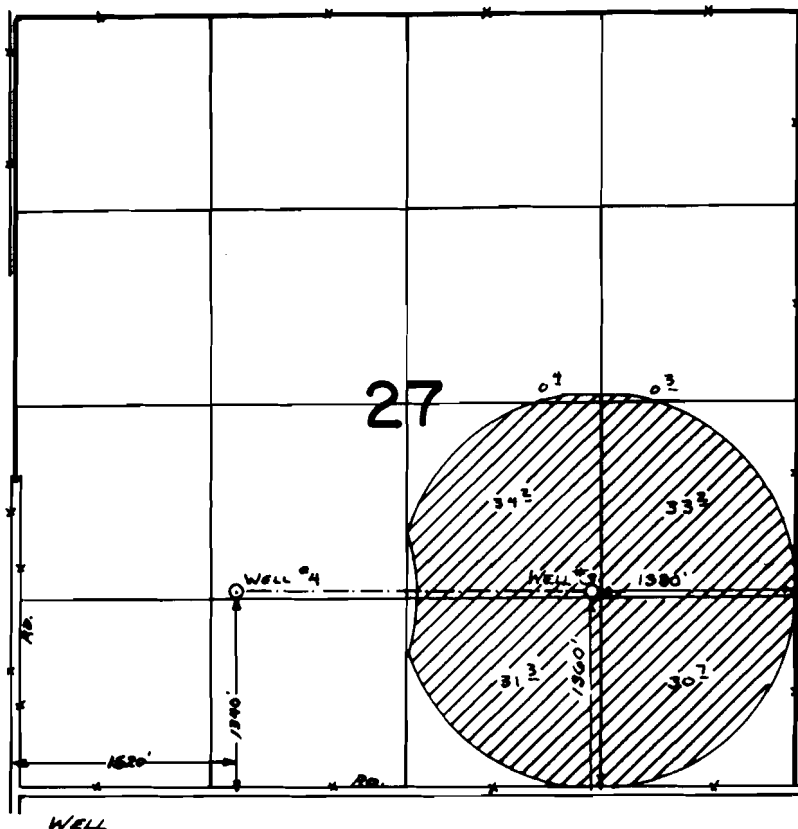

FINAL PROOF SURVEY
UNDER

Application No. G-9225. Permit No. G-8601.....
IN NAME OF

.....RAY B. WAGNER.....

Surveyed Oct. 17, 1983, by L. M. TOLL.....