


G-9121
52877

T.26S., R.19E., W.M.

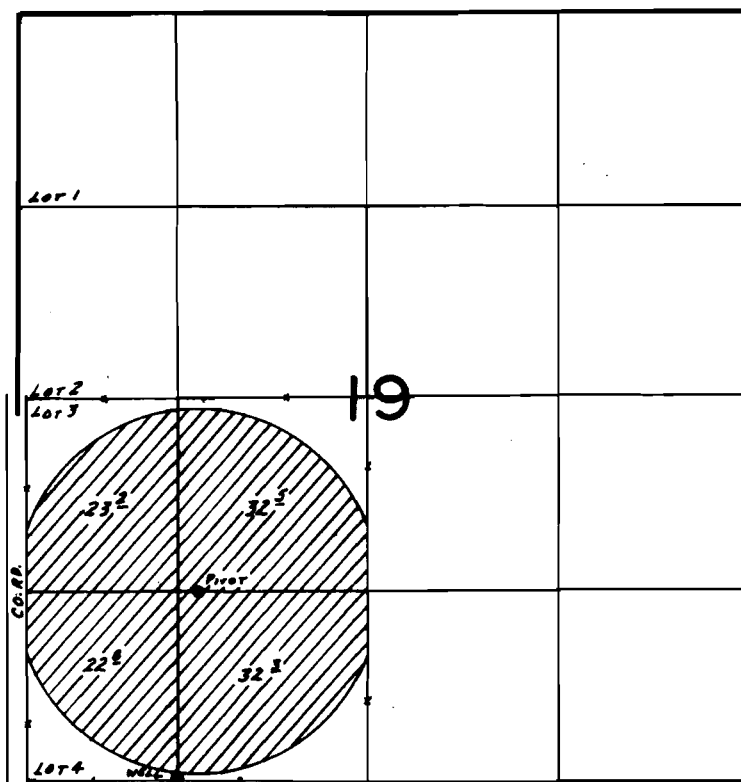

WELL LOC: 50' N. & 1100' E. FROM SW COR. SEC. 19

FINAL PROOF SURVEY
UNDER

Application No. G-9966.. Permit No. G-9121.....
IN NAME OF

.....CLAUDE ALAN BLACKMAN.....

Surveyed OCT. 13... 1984, by B.W. BISHOP.....