


G-9353
52878

T.27S., R.16E., W.M.

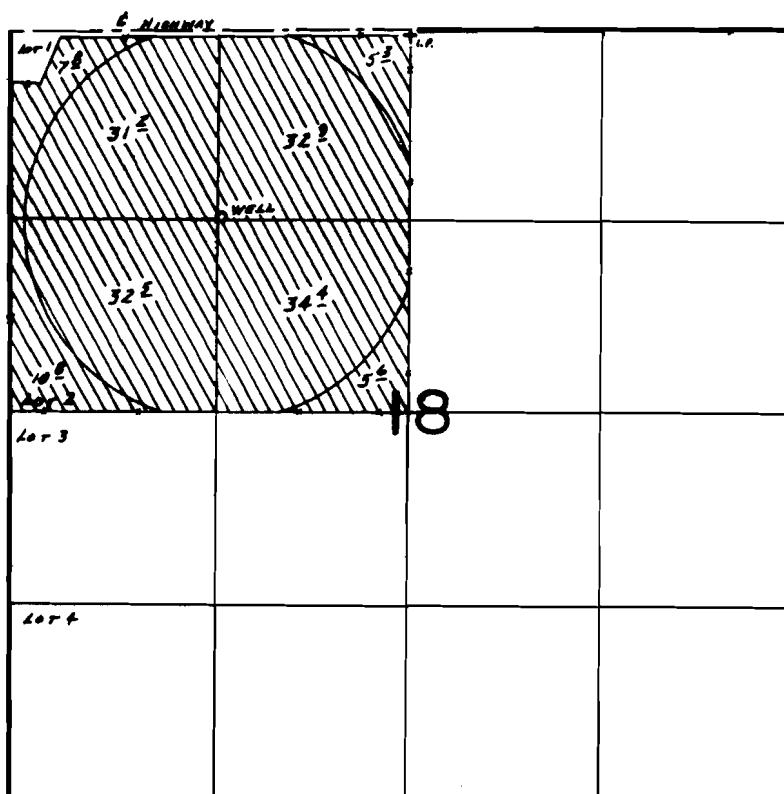

WELL LOC: 1340' N. & 1450' E. FROM N 1/4 COR. SEC. 18

Scale: 1" = 1320'

FINAL PROOF SURVEY

UNDER

Application No. G-10304, Permit No. G-9353.....
IN NAME OF

.....JAMES R. HOWARD.....

Surveyed OCT. 31... 1984, by B.W. BISHOP.....