


G9612
52879

T.27S.,R.19E.,W.M.

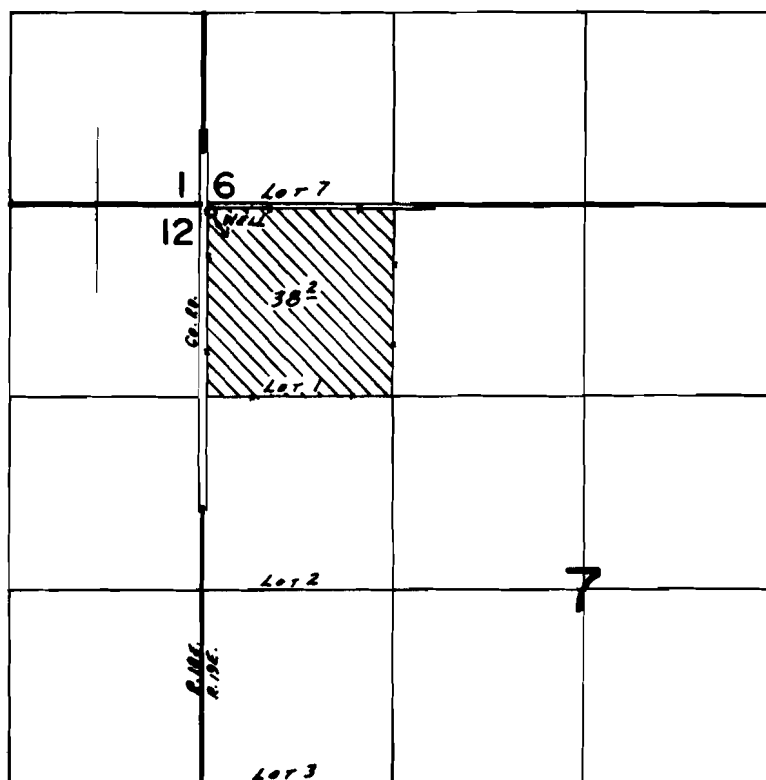

WELL LOC: 30'S. & 30'E. FROM NW COR. SEC. 7

SCALE: 1"=1320'

FINAL PROOF SURVEY
UNDER

Application No. G-10442 Permit No. G-9612.....
IN NAME OF

.....HARLAN F. OSTER.....

Surveyed OCT. 12... 19.84, by B.W. BISHOP.....