


T.16&17S.,R.3W.,W.M.

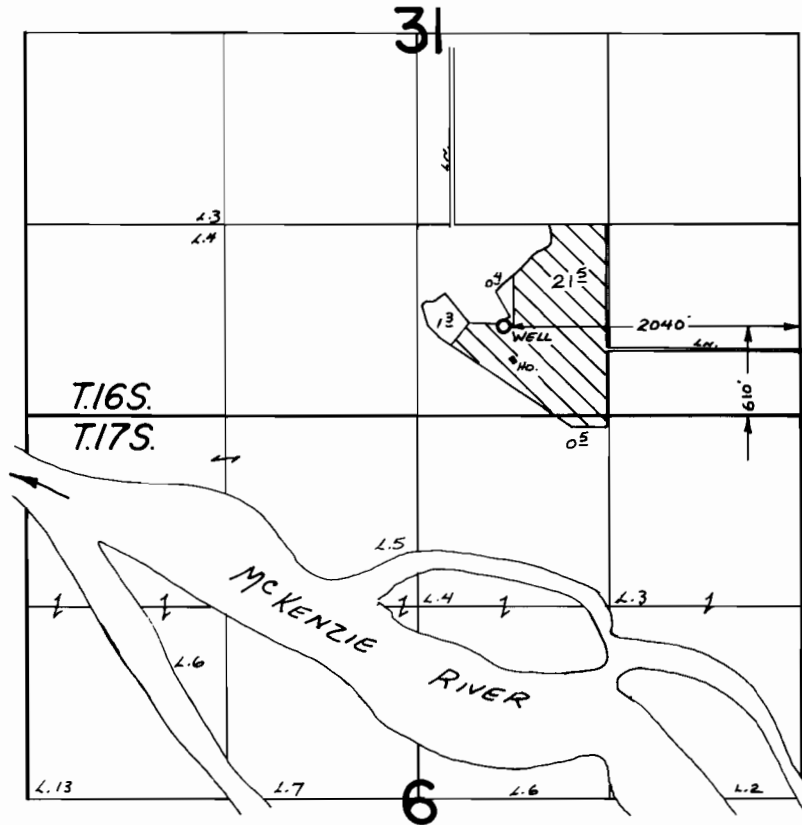

**FINAL PROOF SURVEY**  
UNDER

Application No. G:8176. Permit No. G:7521.....  
IN NAME OF

MICHAEL L. HORTON

Surveyed July...14... 1982., by L.M.TOLL.....