


T.16S. R.6W. W.M.

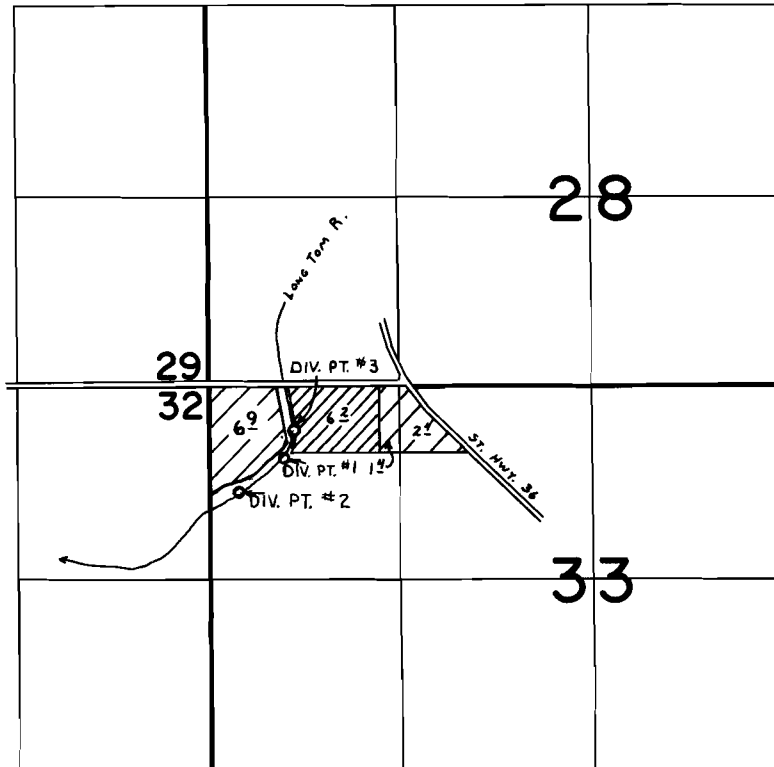

DIV. PT. #3 Loc: 300' S. & 580' E. fr. N.W. Cor. Sec. 33.

DIV. PT. #1 Loc: 480' S. & 520' E. fr. N.W. Cor. SEC. 33

DIV. PT. #2 Loc: 720'S. & 200'E. fr. N.W. CoR. SEC. 33

	46965
	48416

FINAL PROOF SURVEY

UNDER

Application No. **46965** Permit No. **35140**
48416 **35920**
 IN NAME OF

ALTON WM. LOGAN & MARION E. LOGAN

Surveyed June 22, 1979, by C. L. HUGHES.....