


T.16S.,R.7W.,W.M.

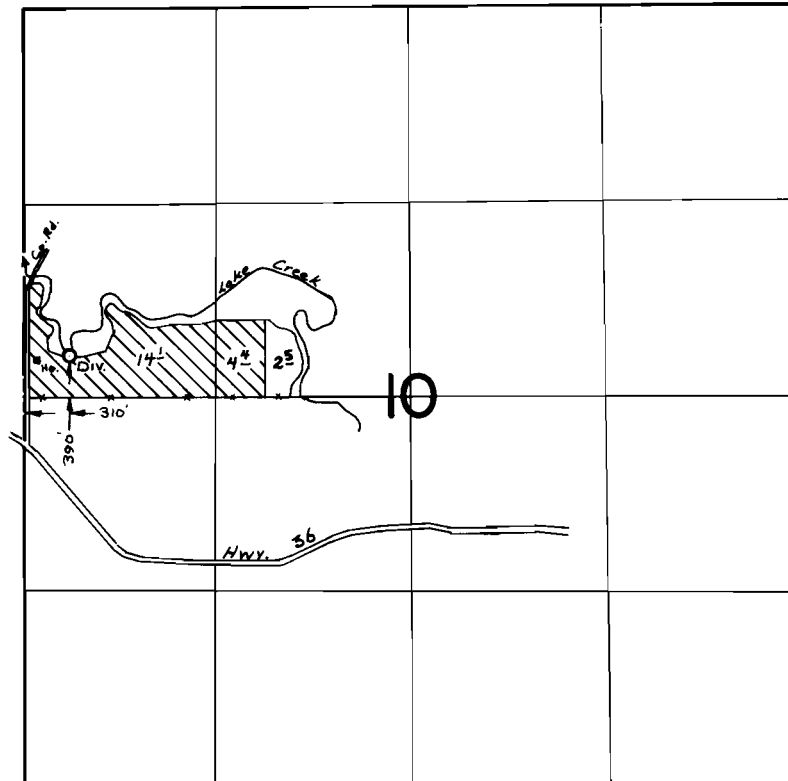

FINAL PROOF SURVEY
UNDER

Application No. 55701.. Permit No. 41724.....
IN NAME OF

RODNEY D. HARDER

Surveyed Aug. 4 1982., by L. M. TOLL.....