


T.14S., R. 9&10W., W.M.

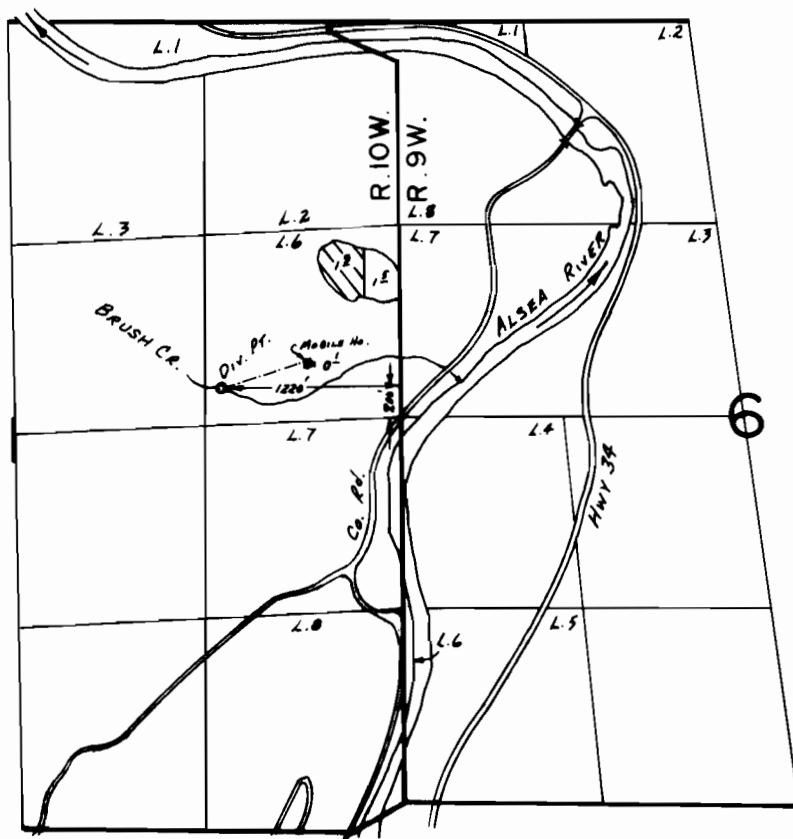

FINAL PROOF SURVEY
UNDER

Application No. 53512... Permit No. 40054.....
IN NAME OF

.....WILLIAM R. GILLILAND.....

Surveyed MAY 21... 19.80, by C.L. HUGHES.....