


T.12S., R.2W., W.M.

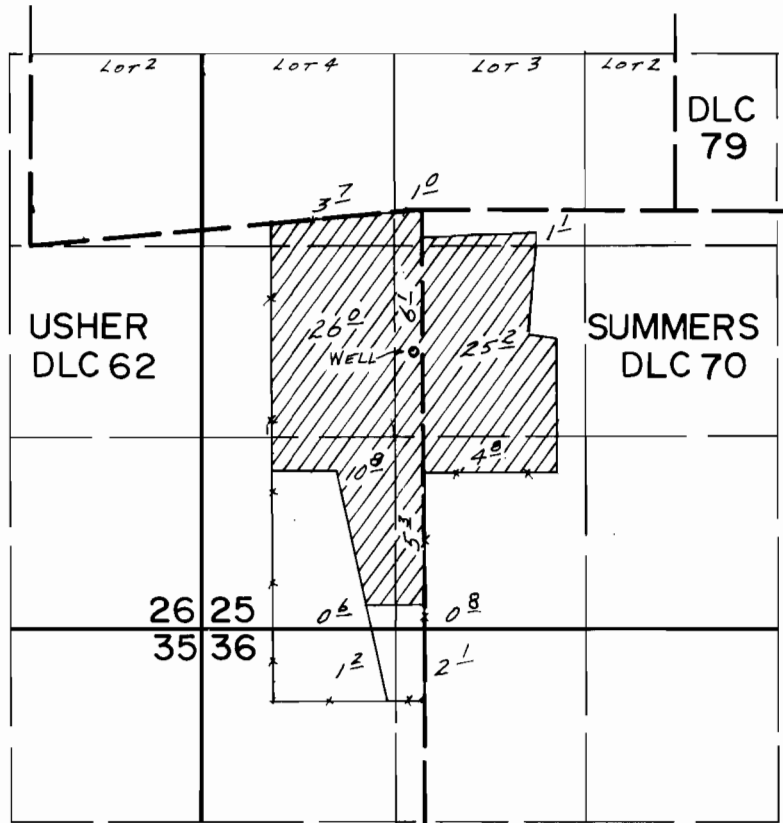

WELL LOC: 970'S. & 50'W. FROM THE NW COR. OF SUMMERS DLC 70

FINAL PROOF SURVEY UNDER

Application No. G-8297 Permit No. G-8012.....
IN NAME OF

ALBERT J. AURICH

Surveyed MAY 17 1982, by L.M. TOLL