T6S. R5W. WM.

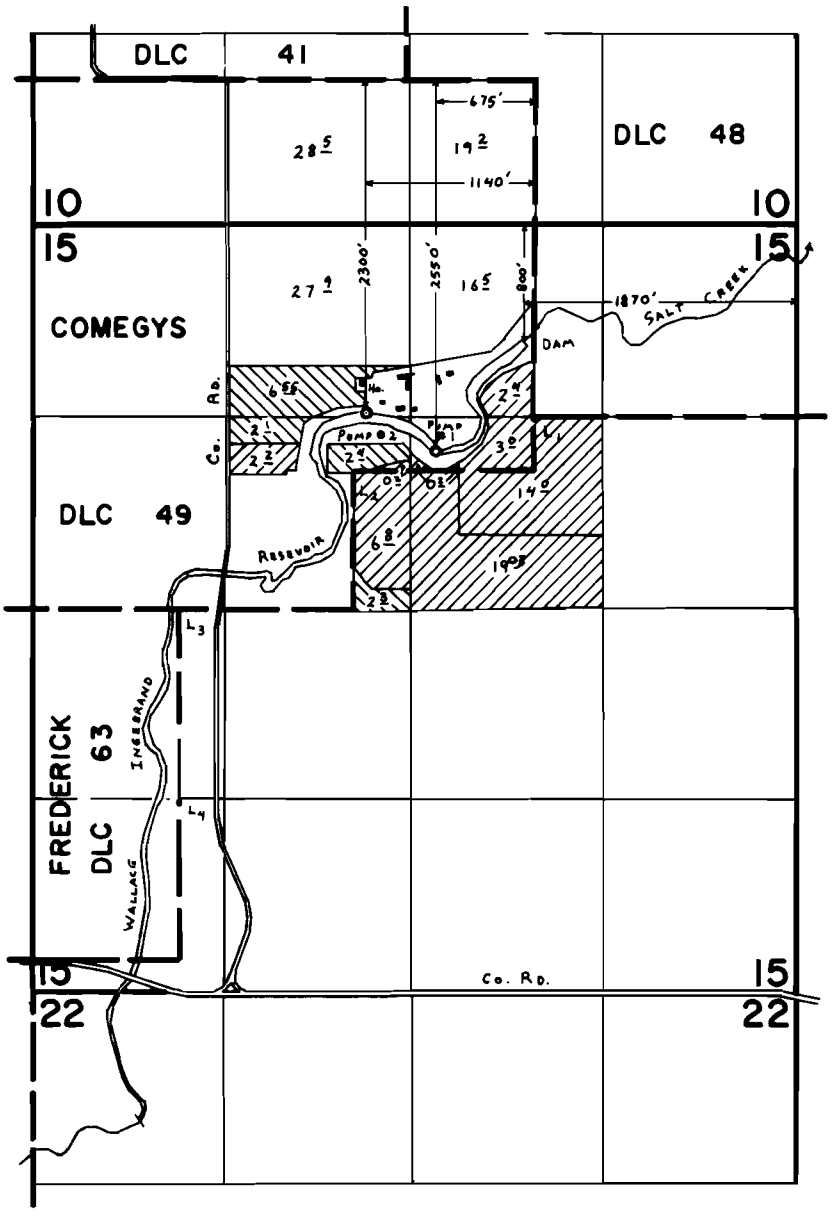

FINAL PROOF SURVEY

UNDER

▨ - PRIMARY IRRIGATION
▨ - SUPPLEMENTAL IRRIGATION

Application No. R-54790 54791 Permit No. R-6584 41554

IN NAME OF

WALLACE INGEBRAND

Surveyed Oct. 5 1979, by C. L. HUGHES

DFP-2LL-4