


T6S. R5W. WM.

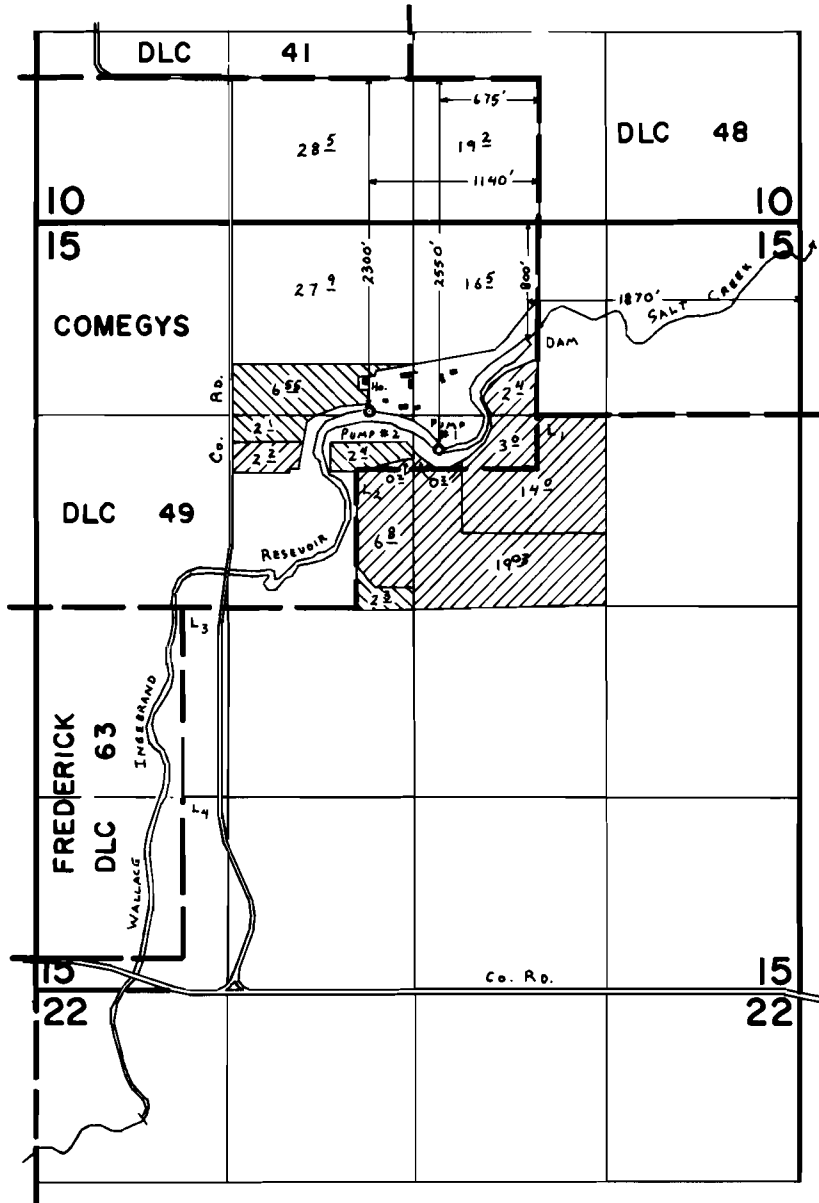

FINAL PROOF SURVEY

UNDER

- PRIMARY IRRIGATION
- SUPPLEMENTAL IRRIGATION

R-54790 R-6584
 Application No. 54791 Permit No. 41554
 IN NAME OF

WALLACE INGEBRAND

Surveyed Oct. 5, 1979, by C. L. HUGHES