


T. 3N. R. 28E. W.M.

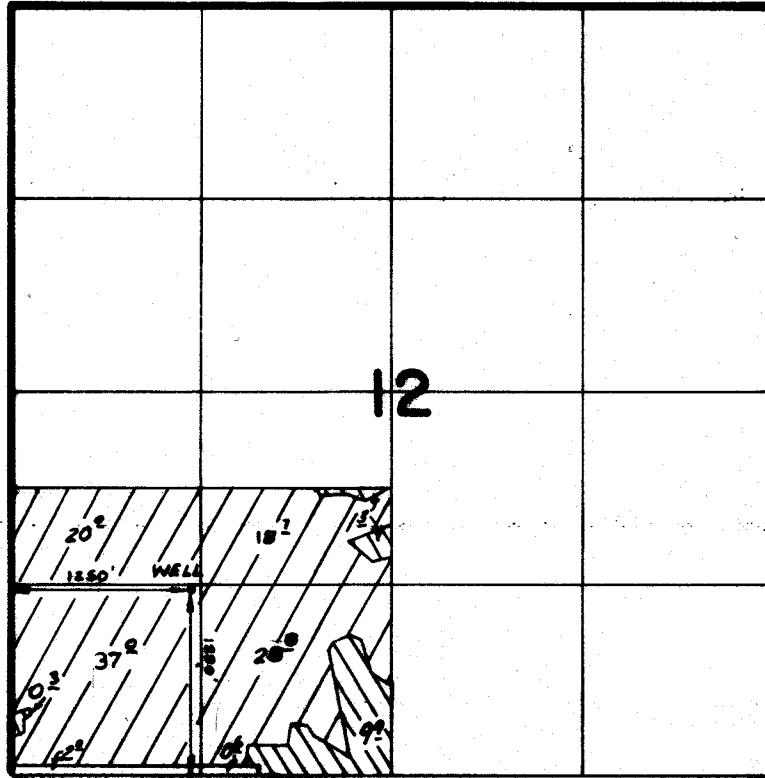

SUPP'L



PRIMARY

FINAL PROOF SURVEY
UNDER

Application No. G-7112... Permit No. G-6574...
IN NAME OF

.....FRANK J. CORREA.....

Surveyed 1-17..... 1979, by R. BARWIN.....