


G 8762
52905

T. 6N., R. 34E., W. M.

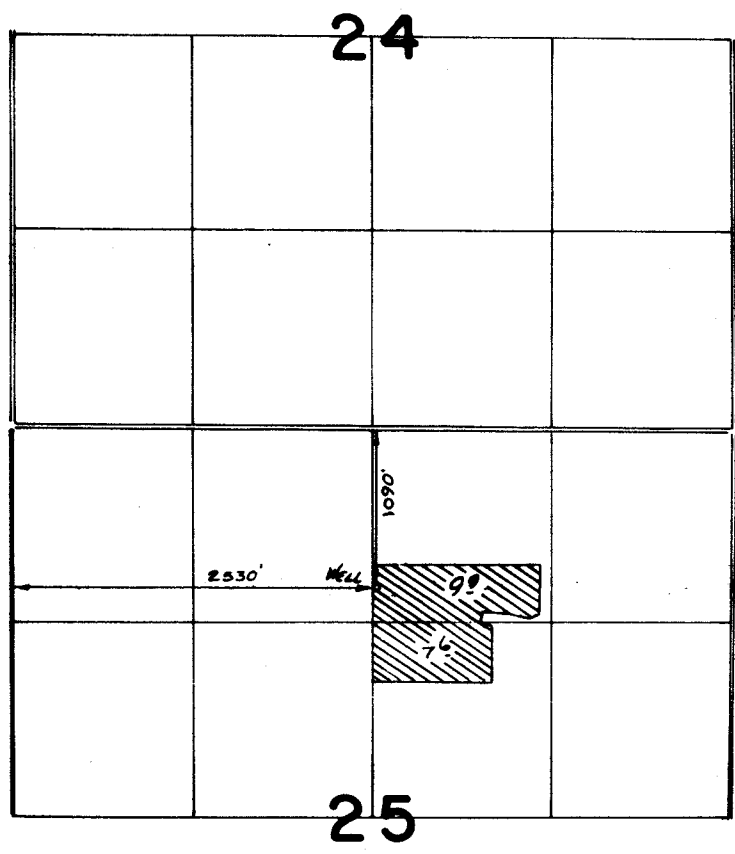

FINAL PROOF SURVEY UNDER

SCALE: 1" = 1320'

Application No. G:9316.. Permit No. G:8762..
IN NAME OF

.....LAWRENCE ENGLISH.....

Surveyed 4-13..... 1984., by V.L. Church.....