


T. 1 N. R. 38 E. W. M.

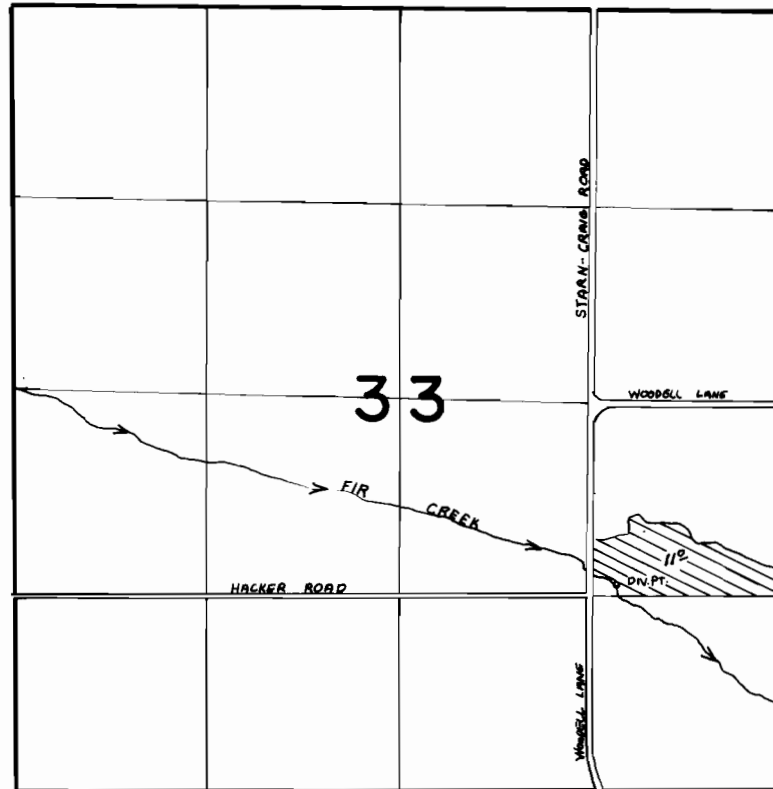

SCALE: 1"=1320'



DIV. PT. LOCATED 1430' N. AND 1140' W. FROM S.E. SEC. COR. SEC. 33

FINAL PROOF SURVEY UNDER

Application No. 51486.. Permit No. 37438.....
IN NAME OF

.....TED & MARY E. LEWANDOWSKI.....

Surveyed 7-12..... 1984.., by V.L. GURCH.....