


T.182S. R.13E. WM.

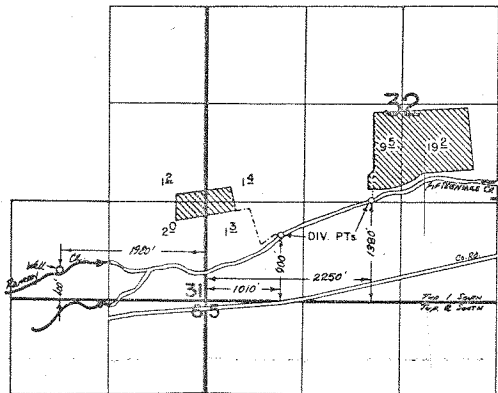

**FINAL PROOF SURVEY**  
UNDER

Application No. 54981... Permit No. 41261...  
IN NAME OF

GENE UNDERHILL

Surveyed June 29 1982, by J. Paul  
Oct. 15, 1984