


T.18&2S. R.13E. W.M.

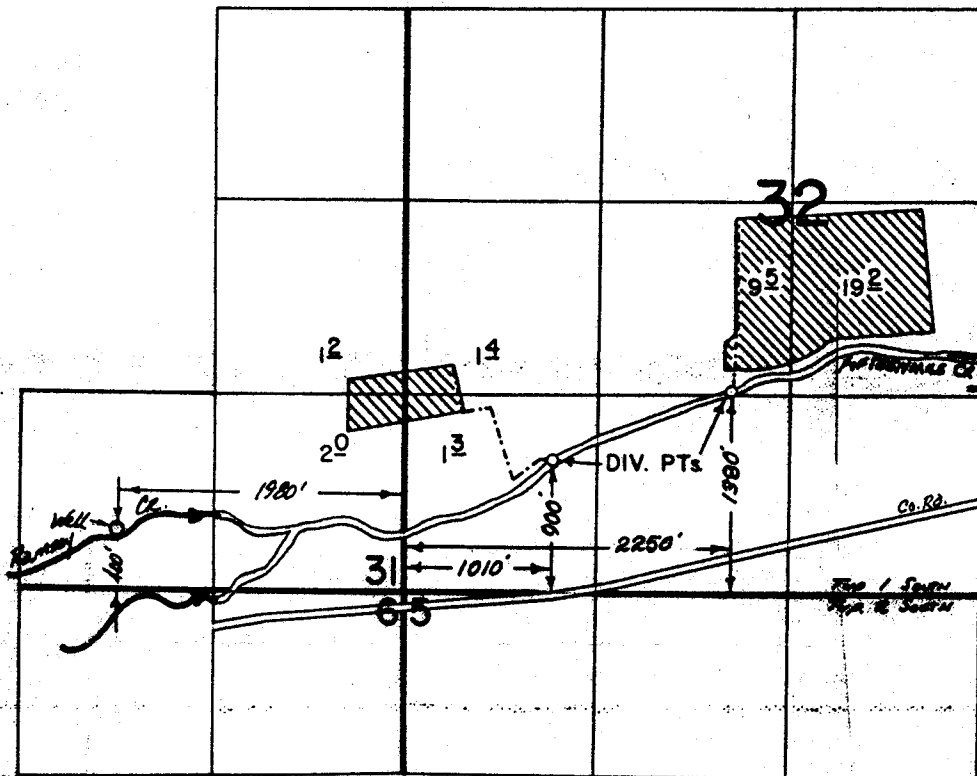

**FINAL PROOF SURVEY**  
**UNDER**

G-9785                      G-6959  
Application No. 54981... Permit No. 41261...  
IN NAME OF

      GENE UNDERHILL      

Surveyed June 29, 1982, by J. Paul  
Oct. 15, 1984