


T.1N.R.4W.W.M.

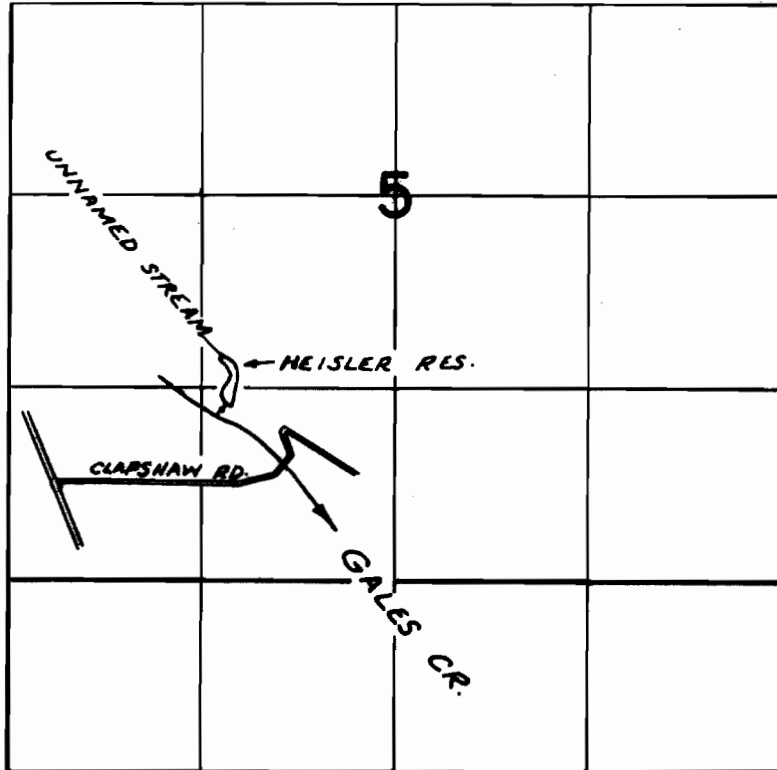

DIV. PT. LOC: 1210' N. & 3790' W. FROM S.E. COR. SEC. 5

FINAL PROOF SURVEY UNDER

Application No. ^{R-56247}~~56246~~ Permit No. ^{R-6666}~~42019~~
IN NAME OF

JOHN M. & LORA C. DANIELS

Surveyed MAY 2, 1977, by R. MUCKEN