


T. 4 S., R. 4 W. WM

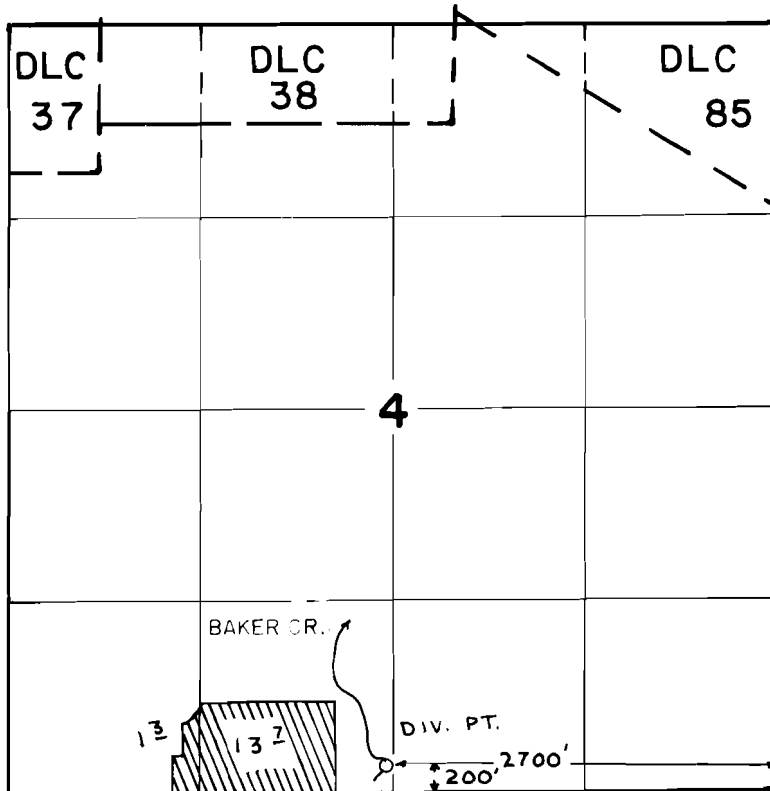

SCALE
1" = 1320'

FINAL PROOF SURVEY
UNDER

Application No. 6046! Permit No. 45782.....
IN NAME OF

GARY LEE WILLIAMSON

Surveyed JUN 19 1984, by P. PAGTER.....