


T. 29 S., R. 6 W., W.M.

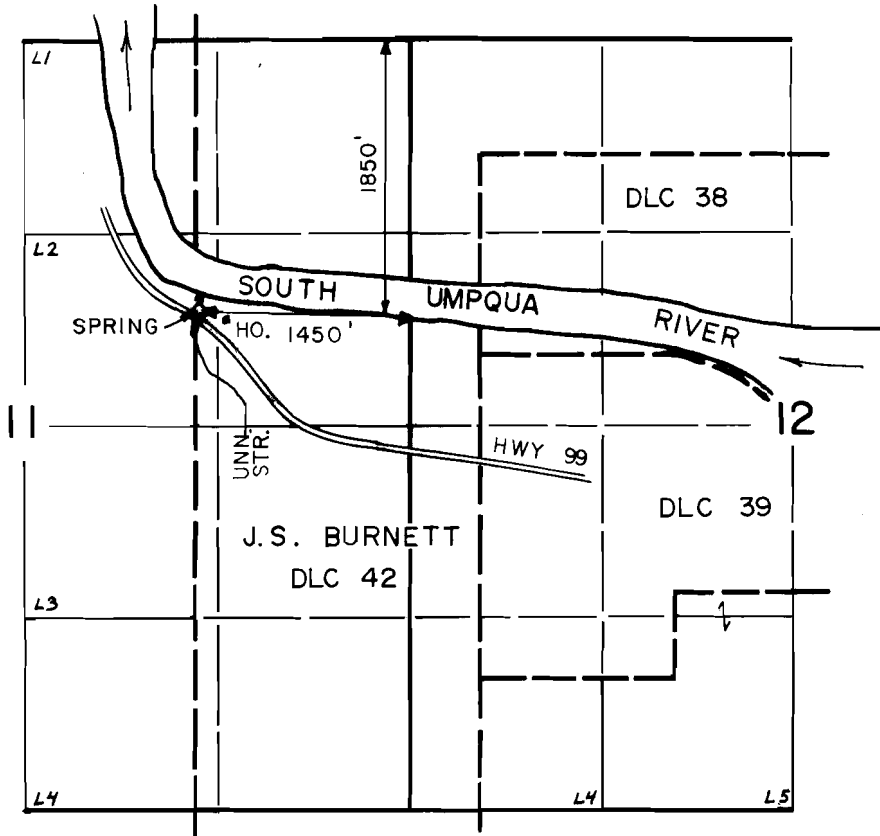

SCALE: 4" = 1 mile

FINAL PROOF SURVEY
UNDER

Application No. 56517... Permit No. 42450.....
IN NAME OF

MARY EMMOTT

Surveyed JULY.....5. 19.84, by *J.E. Cashion*.....