


T.15S. R.16E.W.M.

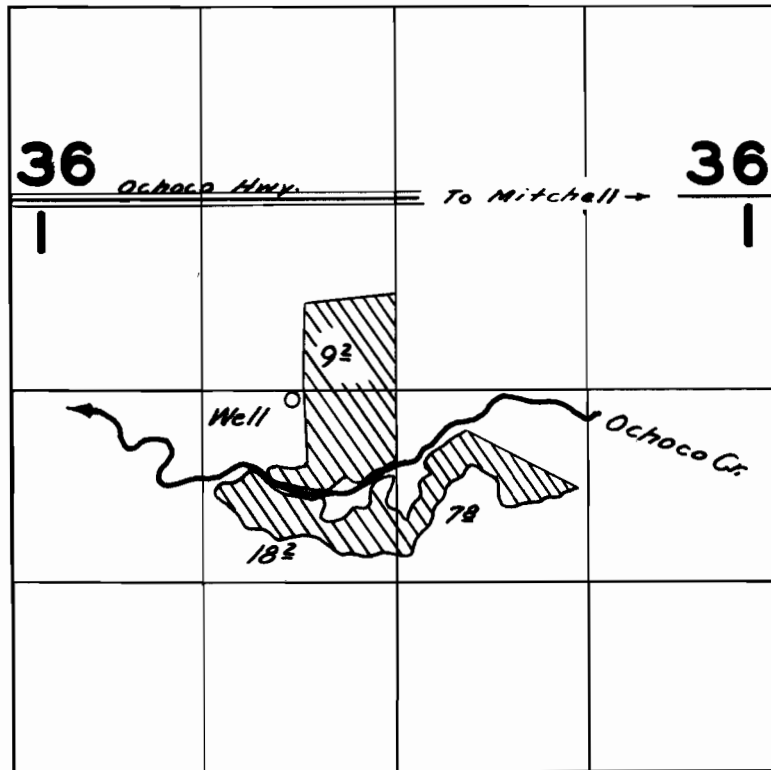

FINAL PROOF SURVEY
UNDER

Application No. U-164 Permit No. U-157
IN NAME OF

Robert Hogan & Ann Dornecker

Surveyed April 23, 1955, by J. Jones