T.25S. R.7W. W.M.

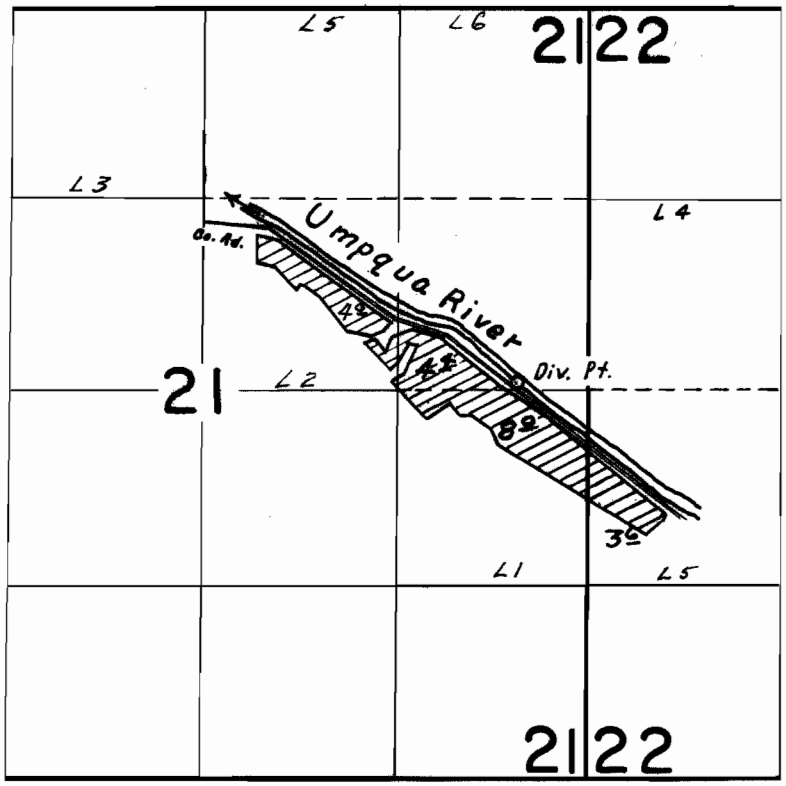

FINAL PROOF SURVEY
UNDER

Application No. 38783 Permit No. 28852
IN NAME OF
LAFE JUDD

Surveyed July 7, 1964 by C. J. Gardner

1964-M