


RECEIVED

JUL 10 1977

T.30 S. R.3 W. W.M.

WATER RESOURCES DEPT.
SALEM, OREGON

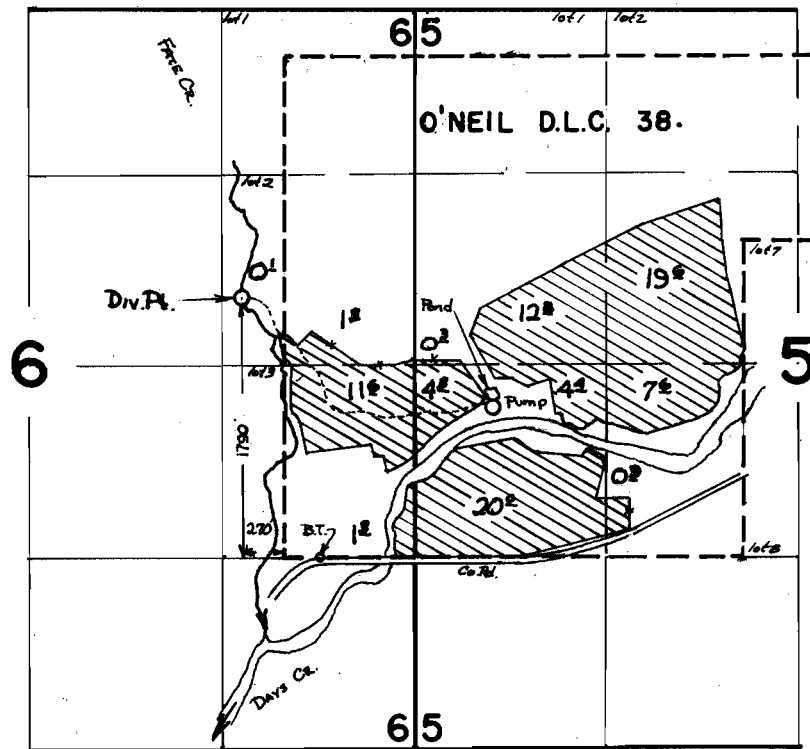

FINAL PROOF SURVEY

UNDER

Application No. 44956 Permit No. 33602

IN NAME OF

FATE CREEK RANCH CORP.

Surveyed 2 JUNE 1970, by D. R. BUELL