


T.36S., R.1E., W.M.

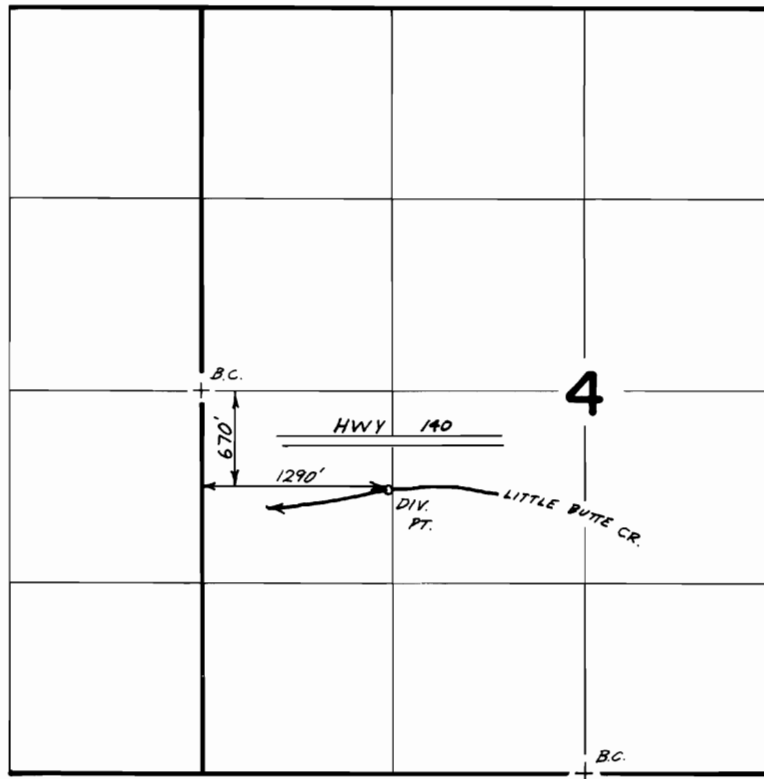

SCALE : 1" = 1320'

FINAL PROOF SURVEY
UNDER

Transfer No. 3955

Application No. Permit No.
IN NAME OF

RICHARD C. & or REATHA KERSHNER

Surveyed July...19... 1984, by B.S. JAMES.....