


# T. 36 S. R. 1 E. W. M.

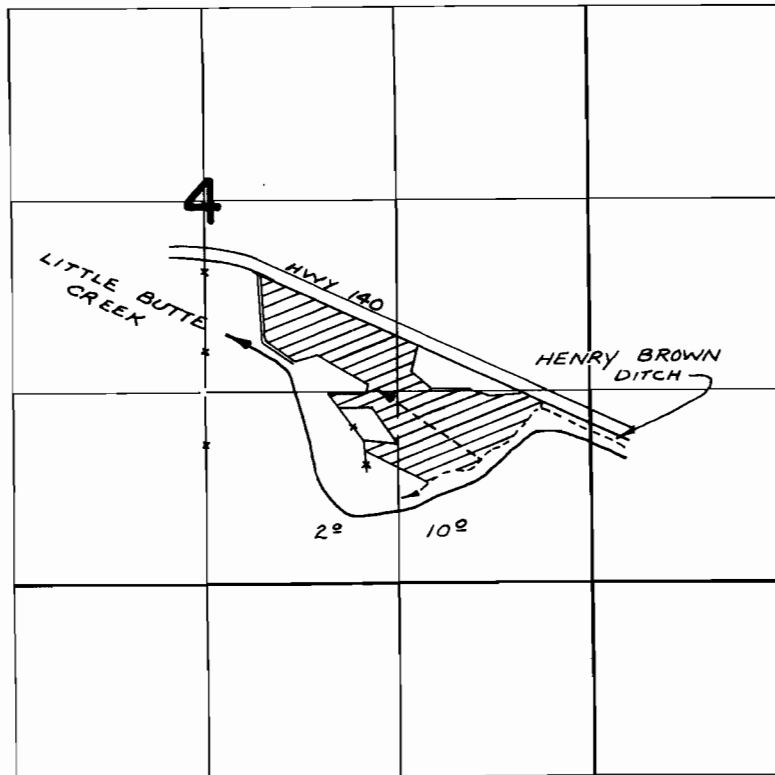

## FINAL PROOF SURVEY UNDER

TRANSFER NO. L-93

Application No. .... Permit No. ....  
IN NAME OF

.....PETE & AUDREY LOGAN.....

Surveyed JUNE 4, 1974, by R. MUCKEN.