


RECEIVED
APR 24 1963
STATE ENGINEER
SALEM, OREGON

TWP 35 S R5 WWM

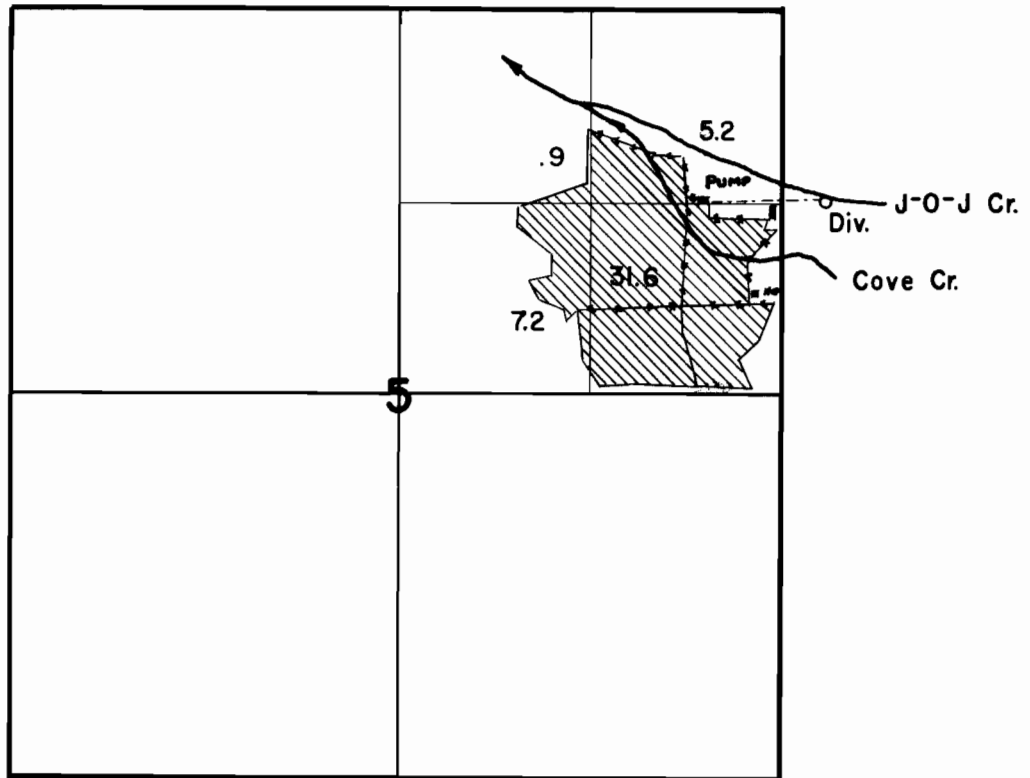

FINAL PROOF SURVEY
UNDER

Application No. 32726..... Permit No. 25890.....
IN NAME OF

.....Frederick George Fudge.....

Surveyed 5-31..... 1962., by R.Steimer.....