


# T. 35S.R.6W.W.M.

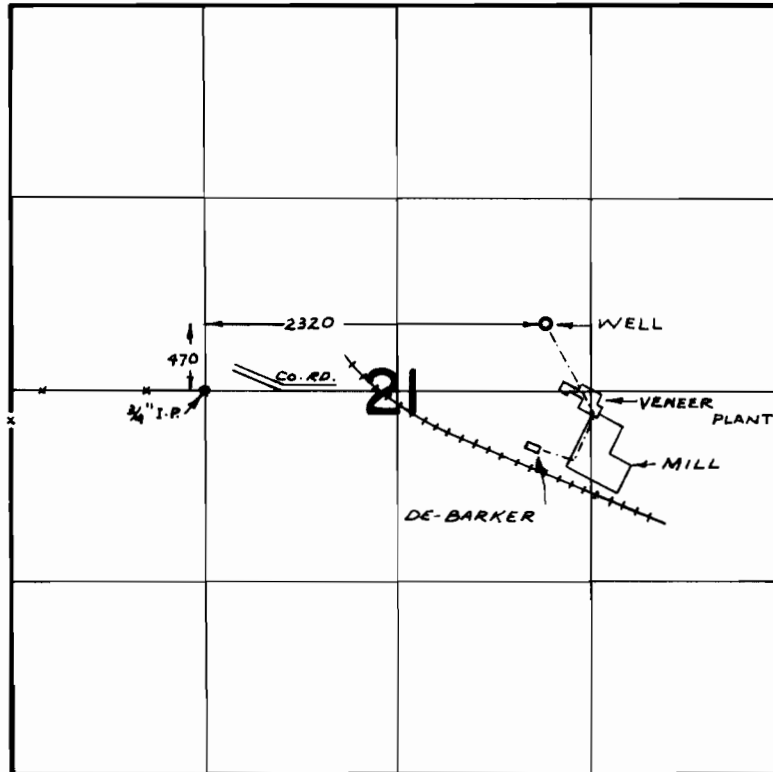

## FINAL PROOF SURVEY UNDER

Application No. G-4432 Permit No. G-4303  
IN NAME OF

BATE PLYWOOD CO., INC.

Surveyed APR. 19, 1972., by R. MUCKEN