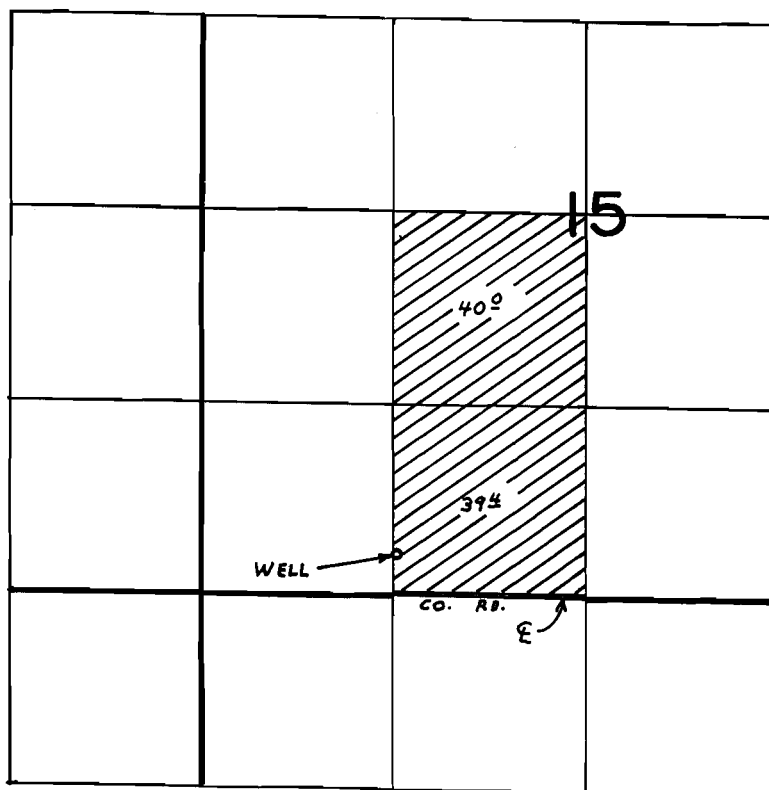


T.25S. R.14E., W.M.

WELL LOC. 280' N. & 1300' W. FROM S $\frac{1}{4}$ COR. SEC. 15**FINAL PROOF SURVEY**
UNDERApplication No. G-7214... Permit No. G-6637...
IN NAME OF


.....ROBERT CARL REED.....

Surveyed JUL. 16, 1977, by D.M. NORBY.....

48464

G 6637

T.25S. R.14E., W.M.

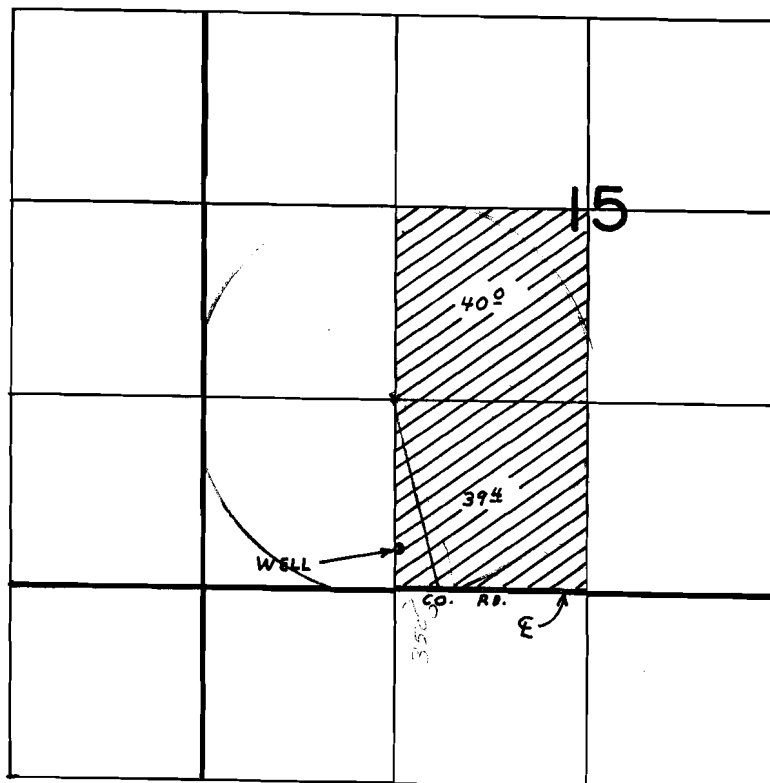

WELL LOC. 280' N. & 1300' W. FROM S $\frac{1}{4}$ COR. SEC. 15

FINAL PROOF SURVEY UNDER



Application No. G-7214... Permit No. G-6637...
IN NAME OF

.....ROBERT CARL REED.....

Surveyed JUL 16, 1977, by D.M. NORBY.....

T 5575
T 5576
G-6637
Cert. 55093
Cert. 53002

T. 25S., R. 14E., W.M.

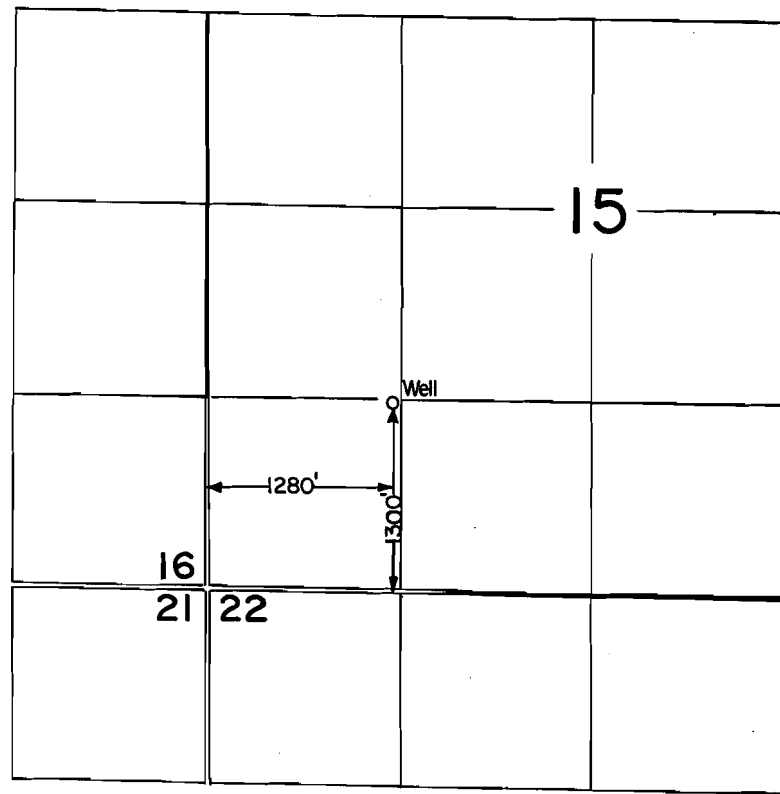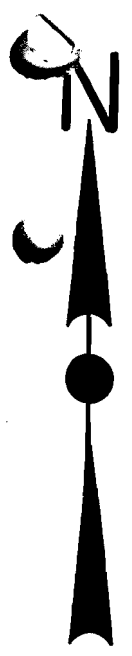

Scale: 1" = 1320'

FINAL PROOF SURVEY
UNDER

Transfers 5575 & 5576

Application No. Permit No.

IN NAME OF

...ROBERT CARL REED...

Surveyed Sept. 18, 1985., by J. Warren.....