


T.10S.,R.1W.,W.M.

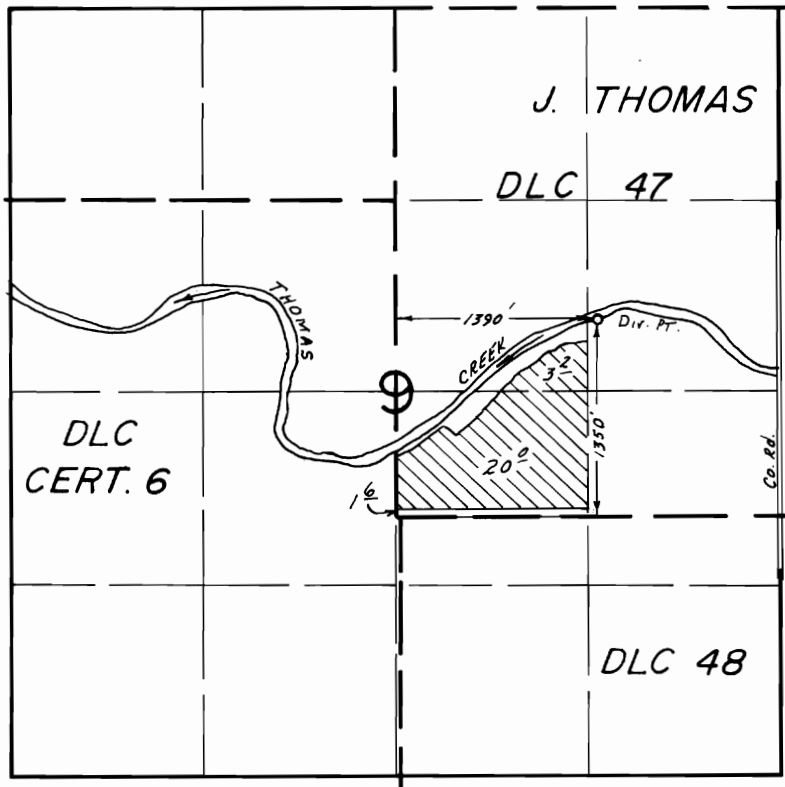

SCALE: 1" = 1320'

FINAL PROOF SURVEY

UNDER

TRANSFER NO. 4766

IN NAME OF

.....M. W. IRWIN.....

Surveyed OCT. 10. 19.83., by M. CAHILL.....

12/27/84
BWB

DFM-322-141