


T. 9 S. R. 1 W. W. M.

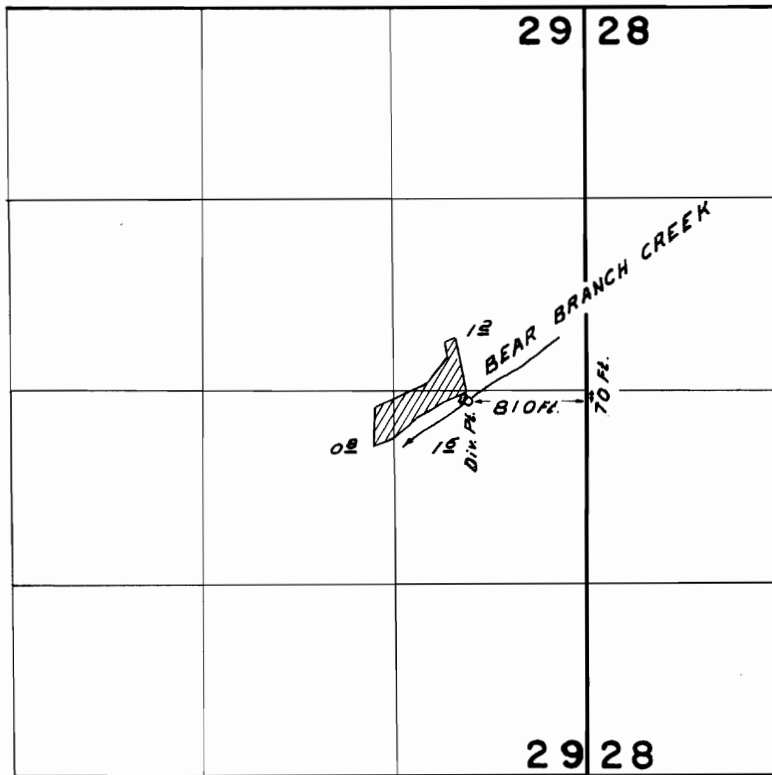

**FINAL PROOF SURVEY**  
UNDER

Application No. 40127 Permit No. 29914  
IN NAME OF

LEONARD LAMBRECHT

Surveyed SEPT. 10 1965, by L. COLEBANK