


T.4N.R.28E.W.M.

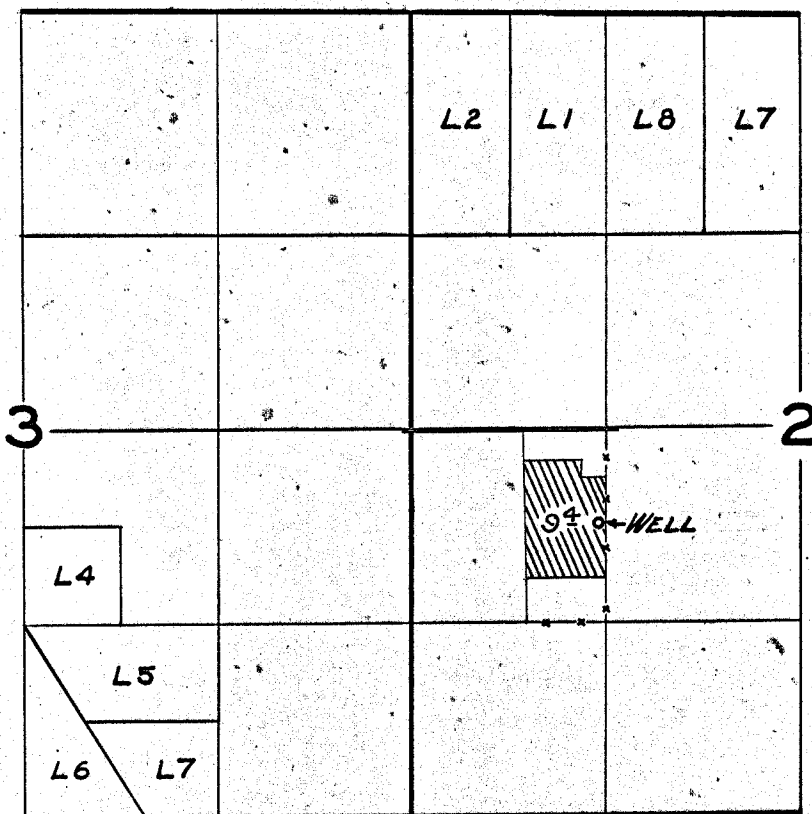

FINAL PROOF SURVEY UNDER

Application No. G-6.62.. Permit No. G-62.8....
IN NAME OF

N. WILLARD & LYDIA ROBERTSON

Surveyed JULY 23 1960, by M. BISH.....