


T.2 S. R.5 W. W.M.

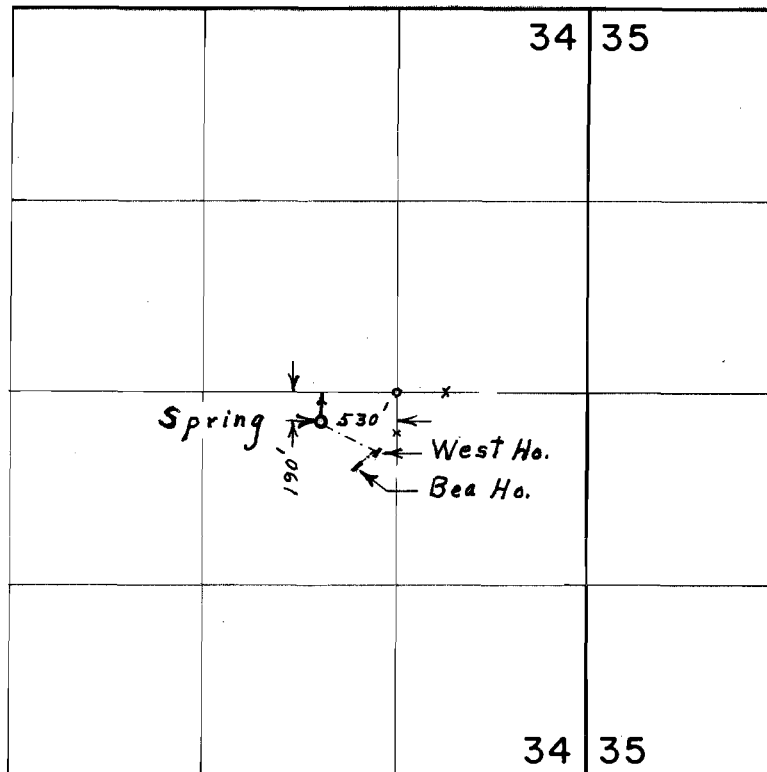

FINAL PROOF SURVEY
UNDER

Application No. 48534 Permit No. 36426
IN NAME OF

ALFRED L. TRIPLET

Surveyed Aug. 4, 1975, by L. E. Gould