


T.5S., R.6W., W.M.

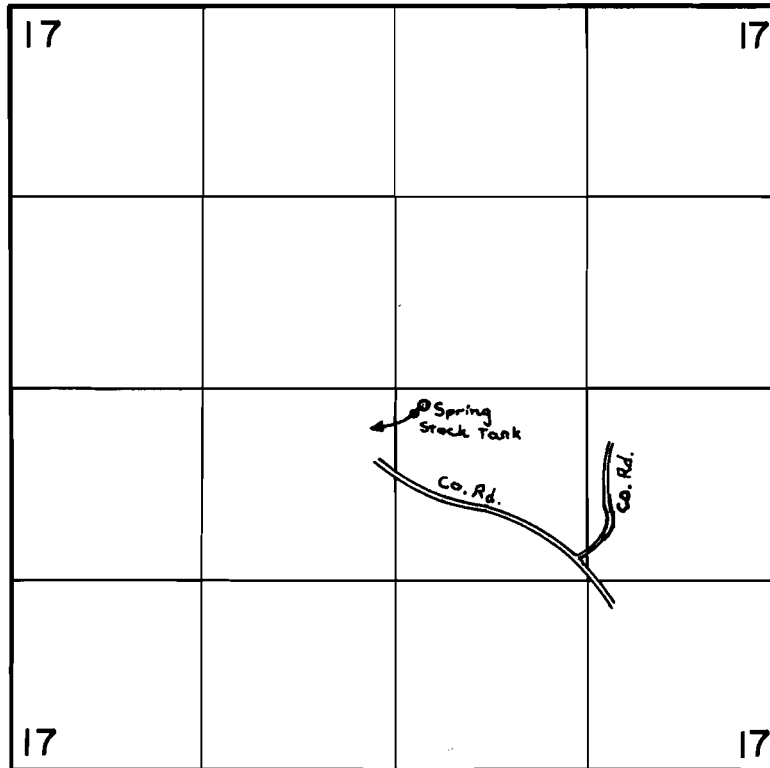

Spring Located: 120'S & 120'E from the C.cor Sec.17

FINAL PROOF SURVEY
UNDER

Application No. 53038 Permit No. 40026
IN NAME OF

LESTER D. TURNIDGE

Surveyed AUG. 5 1976, by D. NORBY