
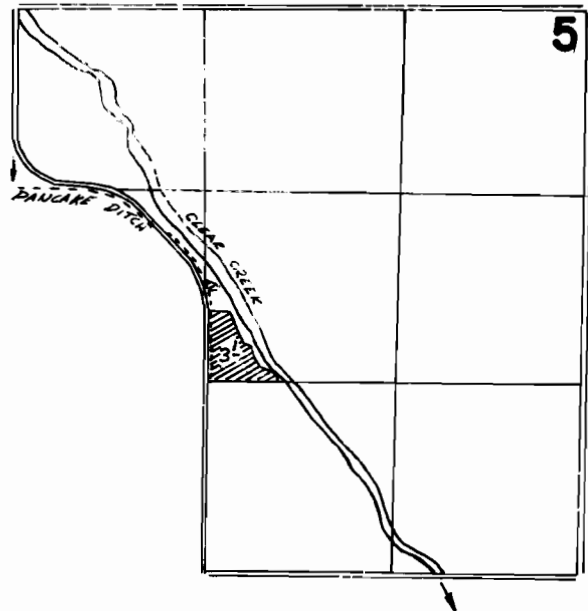


T. 7S. R. 46E. W.M.

T. 8S. R. 46E. W. M.

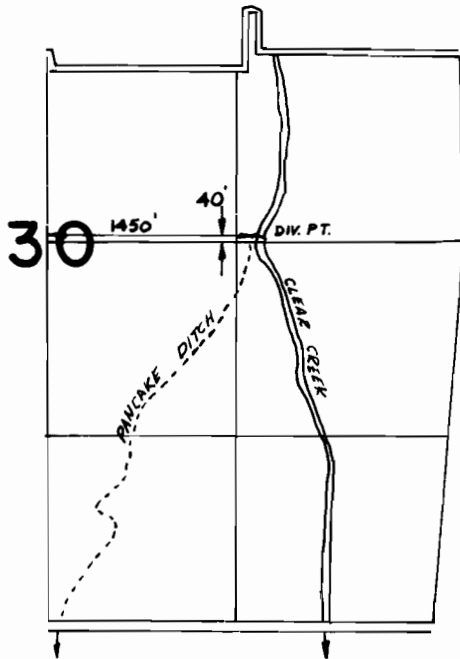

FINAL PROOF SURVEY
UNDER

Application No. 57737 Permit No. 43777
IN NAME OF

CHARLES M. PETERSON

Surveyed 7-27 1979, by V. Church & D. Jarrett