T14S. R5W. WM.

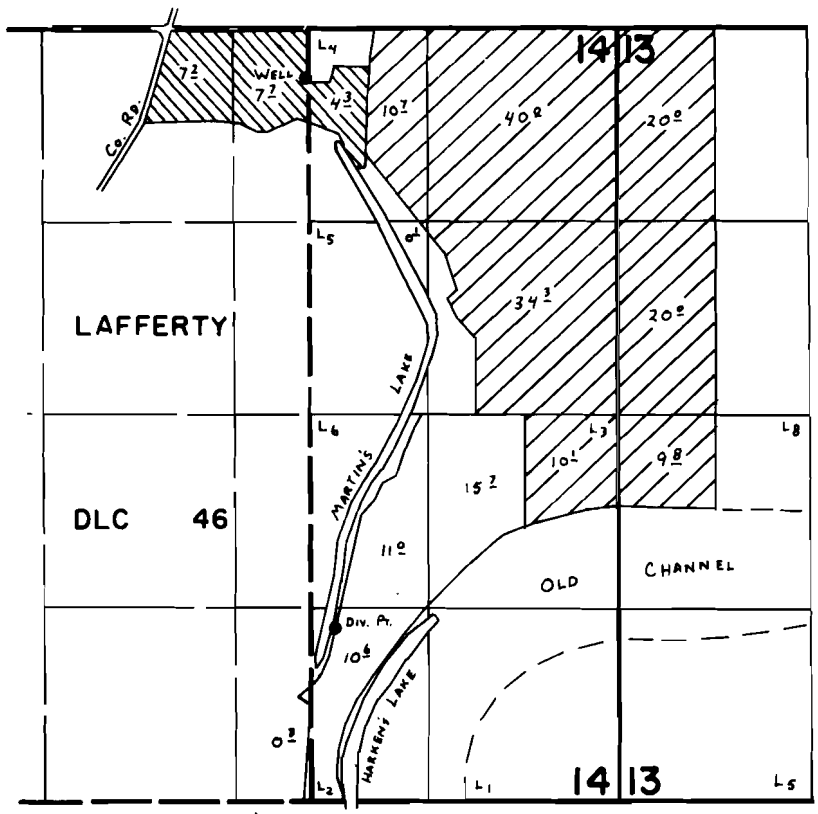

WELL LOC: 340'S. & 20'W. fr. N.E. COR. LAFFERTY DLC 46
DIV. PT. LOC: 1190'N. & 160'E. fr. S.W. COR. LAFFERTY DLC 46
▨ - PRIMARY IRRIGATION fr. WELL (APP. G-8662)
▨ - SUPPLEMENTAL IRRIGATION fr. MARTIN'S LAKE DIV. PT. (APP. 57504)

FINAL PROOF SURVEY

UNDER

Application No. G-8662 57504 Permit No. G-8317 43515

IN NAME OF

WILLIAM H. VOLKER

Surveyed Sept. 6 1979, by C. L. HUGHES

DFJ-2LL-52