


T.5S. R.1E. & 1W. W.M.

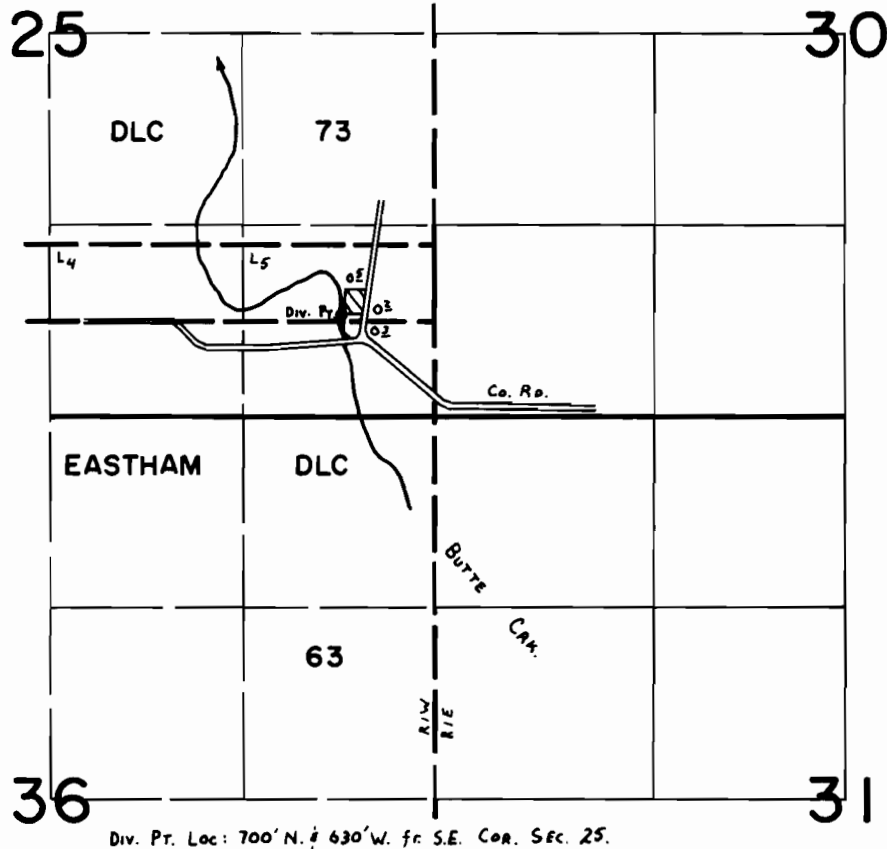

Div. Pt. Loc: 700' N. & 630' W. fr. S.E. Cor. Sec. 25.

FINAL PROOF SURVEY
UNDER

Application No. **51082** Permit No. **38541**.....

IN NAME OF

EFFIE ERNTSON.....

Surveyed **Oct. 12, 1979**, by **C. L. HUGHES**.....